


T. 3S. R. 1E. W.M.

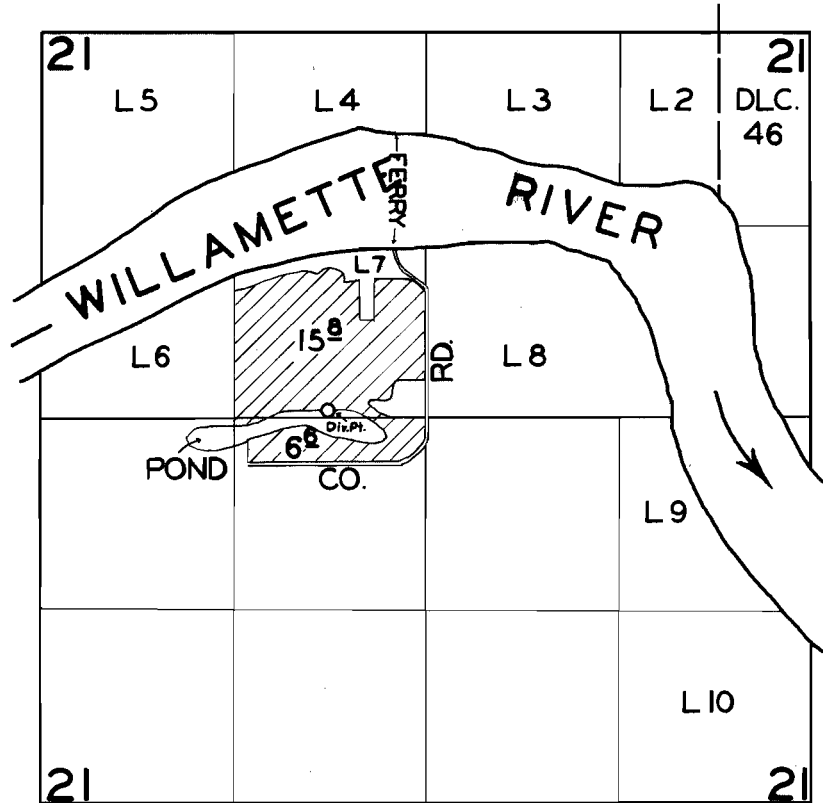

FINAL PROOF SURVEY

UNDER

Application No. 25378 Permit No. 19993

IN NAME OF

HERWIG R. NETTER AND/OR ELSIE NETTER

Surveyed 14 MAY 1956, by R.D. BEST

RDS