


T.4S.R.4 W.W.M.

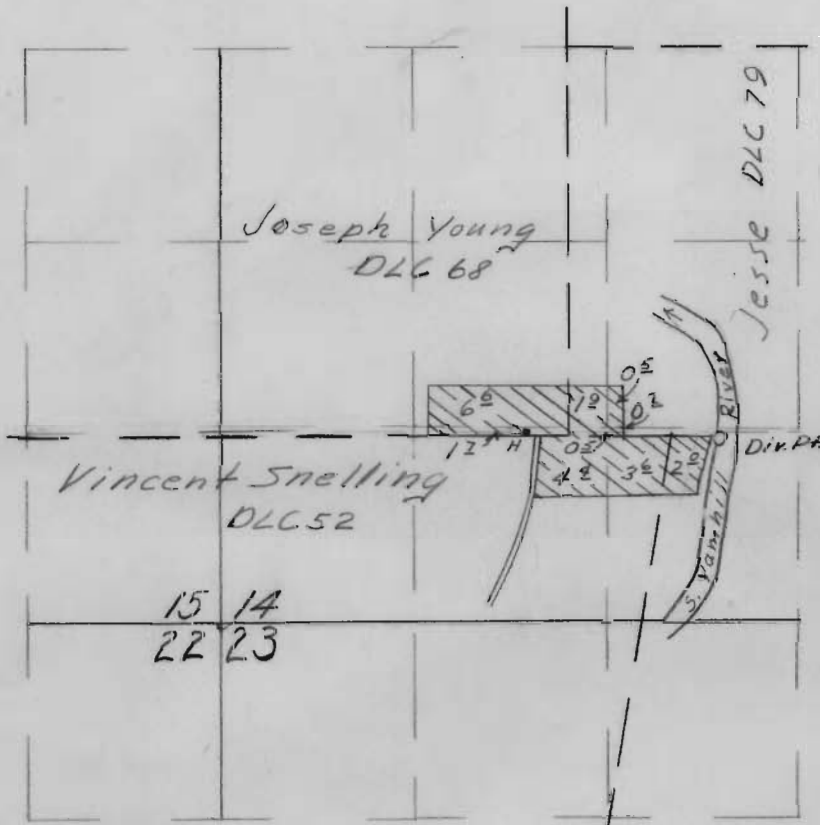

Final Proof Survey  
Under

Application No. 25521 Permit No. 20048  
In Name Of

Arthur Mosher & Carl Howard

Surveyed June 9, 1955 by T. Jones

DFG-3D-141

CB