



T. 1 S., R. 4 W., W.M.

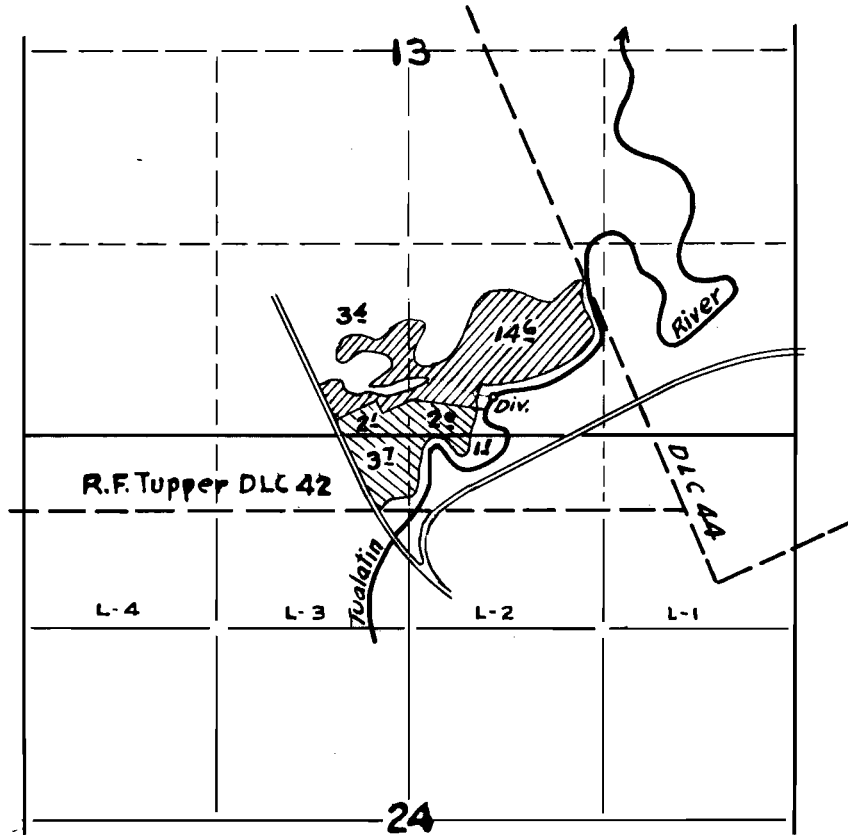

FINAL PROOF SURVEY

UNDER

Application No. 23708 25621 Permit No. 18722 20099 

IN NAME OF

M.P. & Erma R. Daughters

Surveyed 4-19 1956, by R.D. Best