


T.5 N. R. 7 W. W.M.

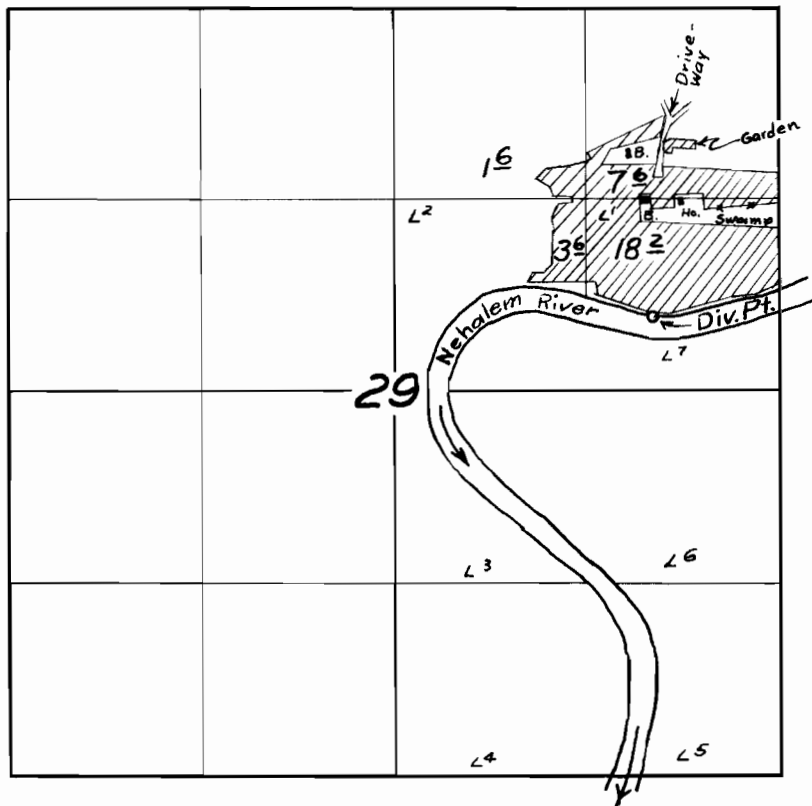

FINAL PROOF SURVEY

UNDER

Application No. 25663 Permit No. 20123

IN NAME OF

Fred P. Courtwright

Surveyed 12 July 1956, by M. Bish