


T. 4 S. R. 5 W. W.M.

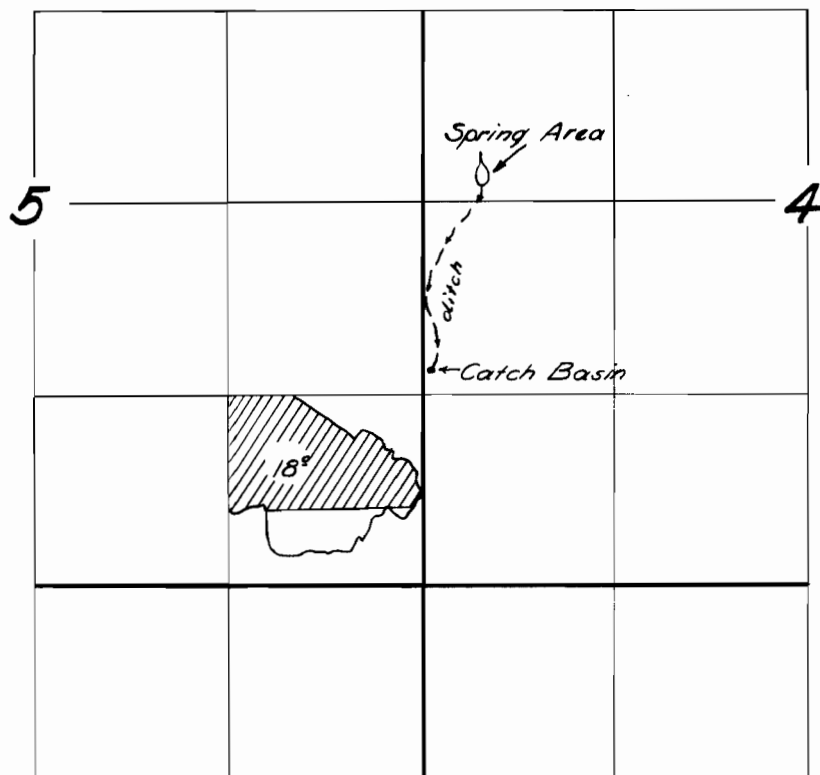

FINAL PROOF SURVEY
UNDER

Application No. 25495 Permit No. 20220
IN NAME OF

ERNEST SHELBURNE

Surveyed 29 Mar 1956, by *C. H. Hilby*