


T. 6 N. R. 6 W. W. M.

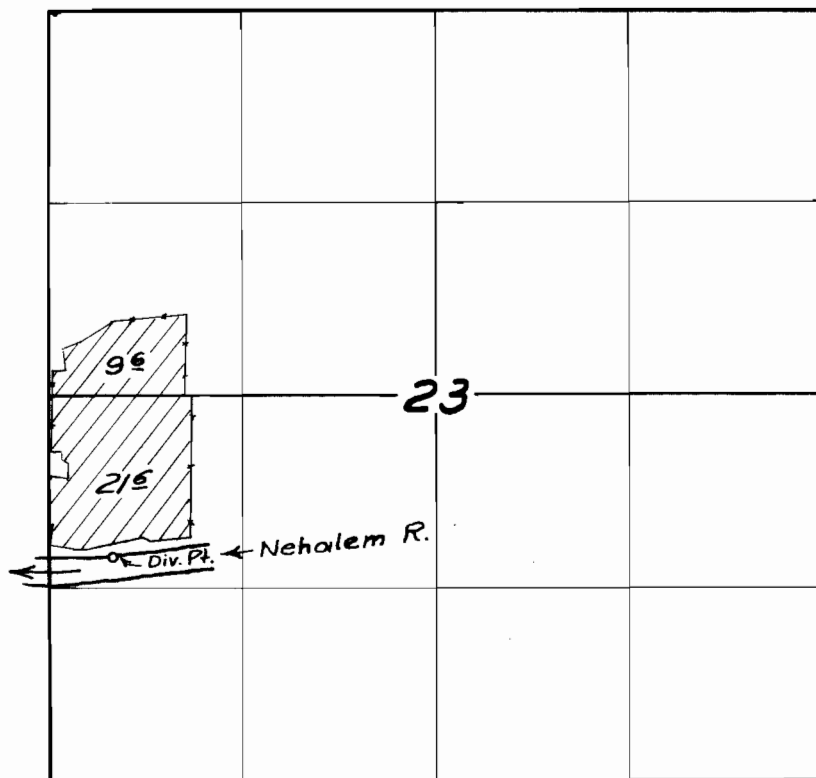

FINAL PROOF SURVEY
UNDER

Application No. 26012 Permit No. 20375
IN NAME OF

Robert G. DuPuis

Surveyed 16 Aug. 1956, by T. A. Bish