


T. 4S. R. 3E. W.M.

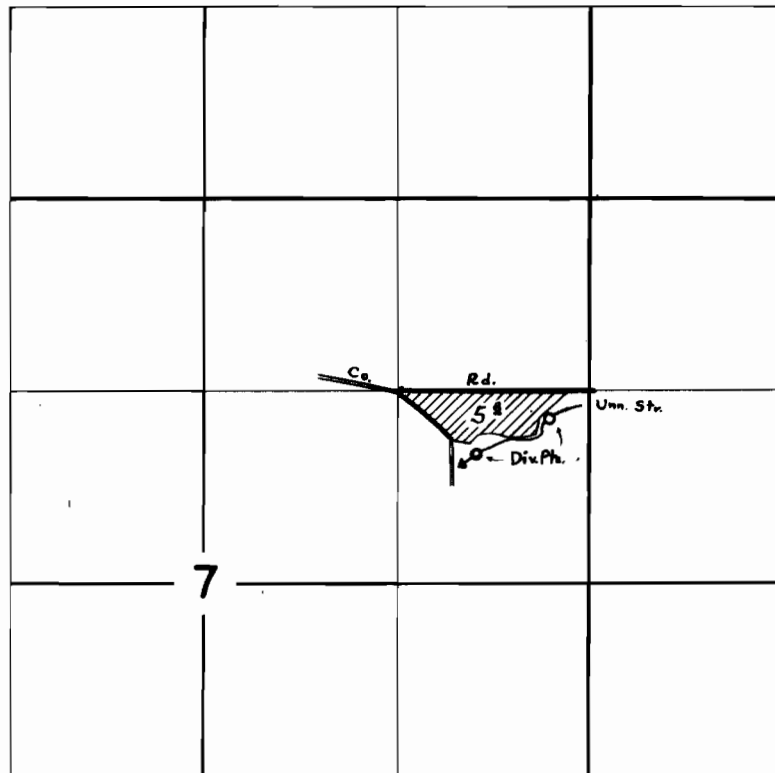

FINAL PROOF SURVEY

UNDER

Application No. 26319 Permit No. 20456

IN NAME OF

ROY A. SCHELL

Surveyed 3 APR. 1956, by R.D. BEST

DFK-ID-87

Best