


T. 5 S. R. 1 W. W. M.

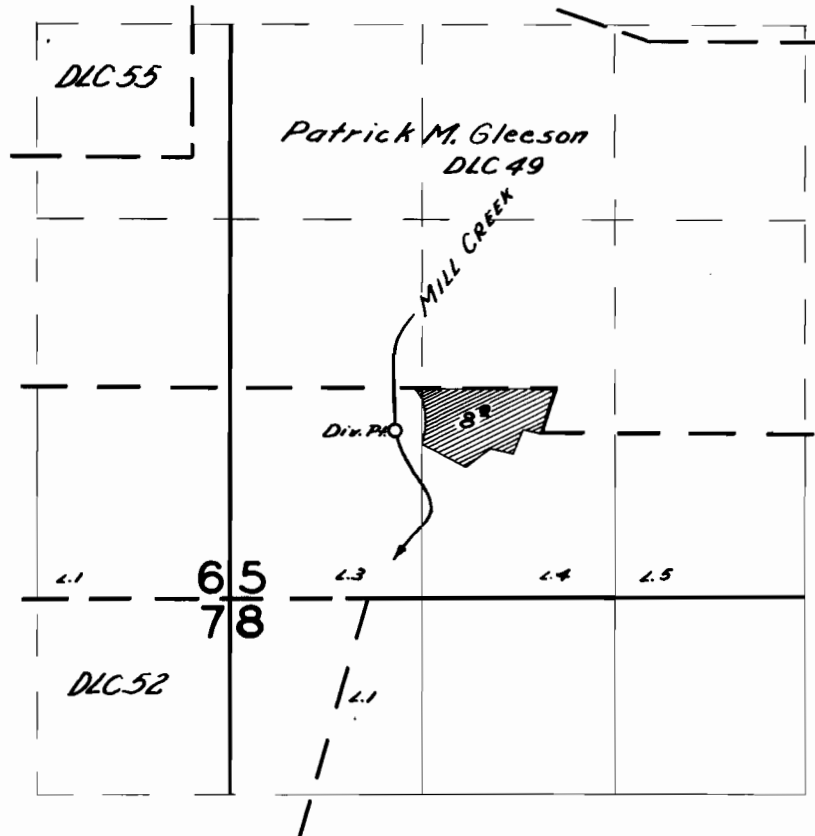

FINAL PROOF SURVEY

UNDER

Application No. 25705 Permit No. 20519

IN NAME OF

Lewis & Olive Garber

Surveyed May 29 1956, by C.O. Bartels