


T. 4S. R. 1E. W.M.

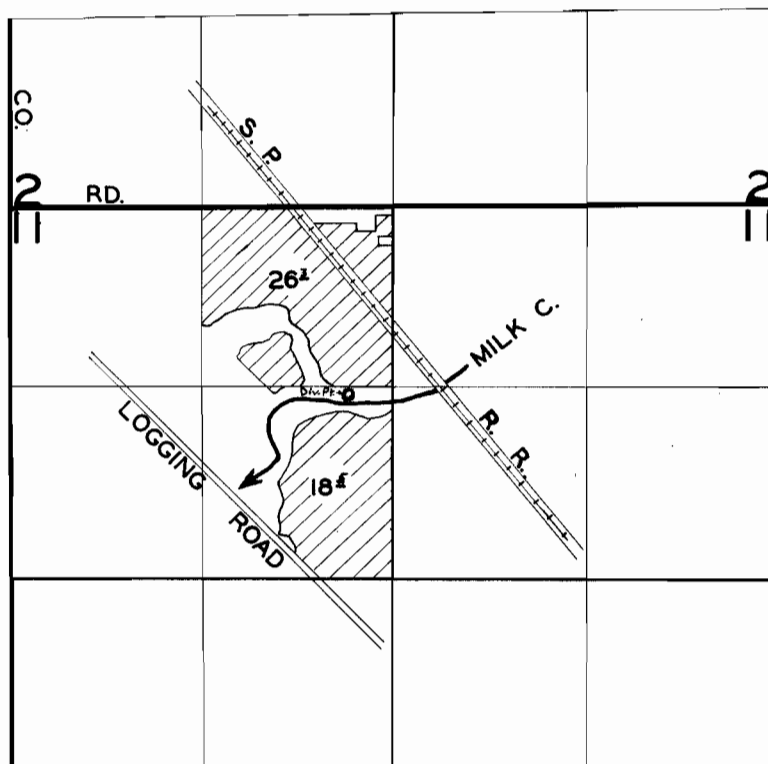

FINAL PROOF SURVEY
UNDER

Application No. **25862** Permit No. **20530**
IN NAME OF

BERTHA MARKS

Surveyed **8 MAR. 1956**, by **R.D. BEST**