


T.5S.R.3 W.W.M.

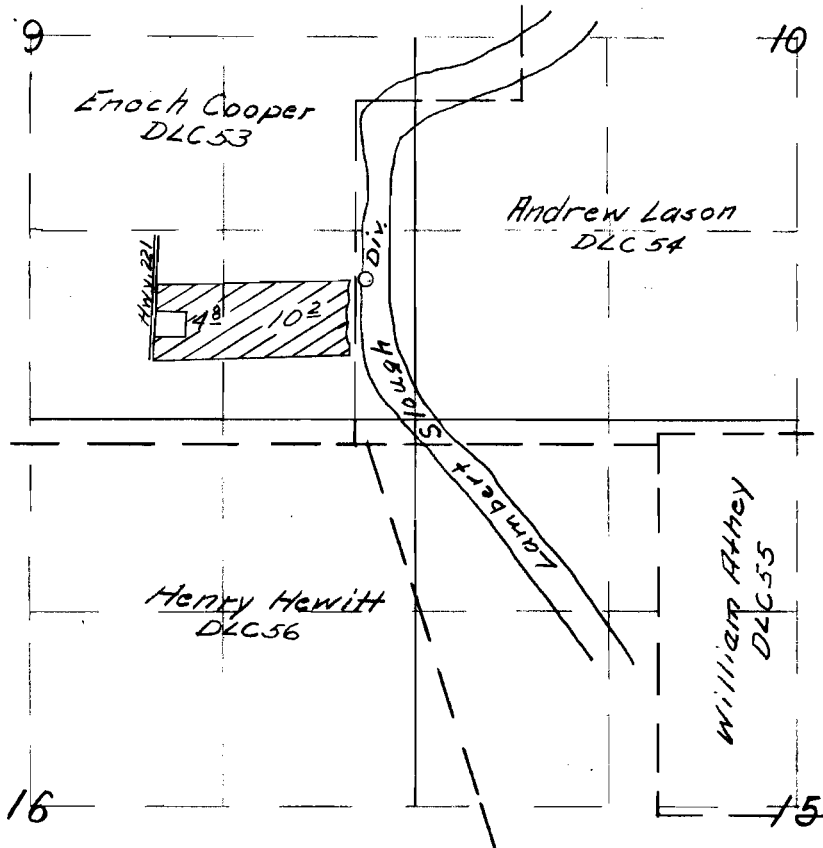

FINAL PROOF SURVEY  
UNDER

Application No. 25895 Permit No. 20536  
IN NAME OF

Ida G. Fowler

Surveyed May 25 1955, by T. Jones