


T. 5 S. R. 3 W. W. M.

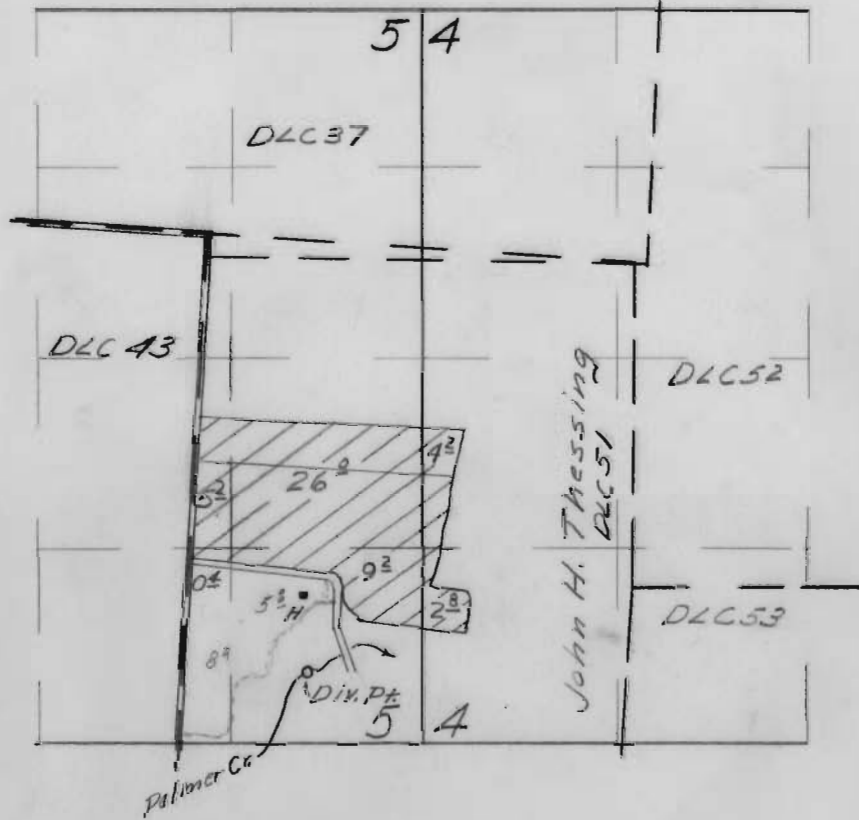

Final Proof Survey
Under

Application No. 26076 Permit No. 20569
In Name Of

Peter & Essie B. Ediger

Surveyed May 25 1953 by T. Jones