


T. 4S. R. 3E. W.M.

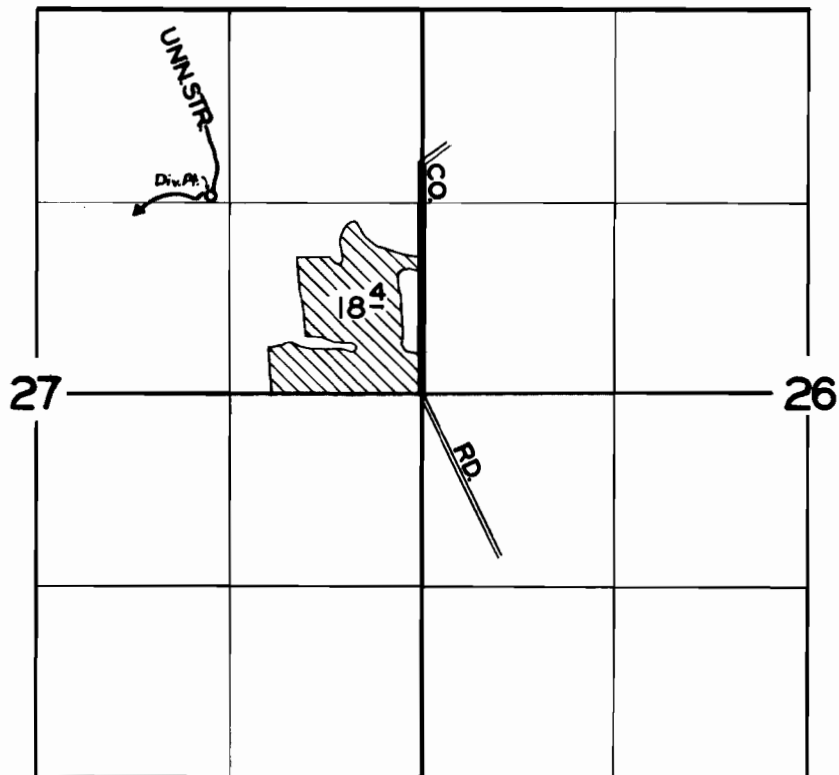

FINAL PROOF SURVEY
UNDER

Application No. 26638 Permit No. 20870
IN NAME OF

EVERETT FREEZE

Surveyed 3 APR. 1956, by R.D. BEST