


T. 5 S. R. 5 W. W. M.

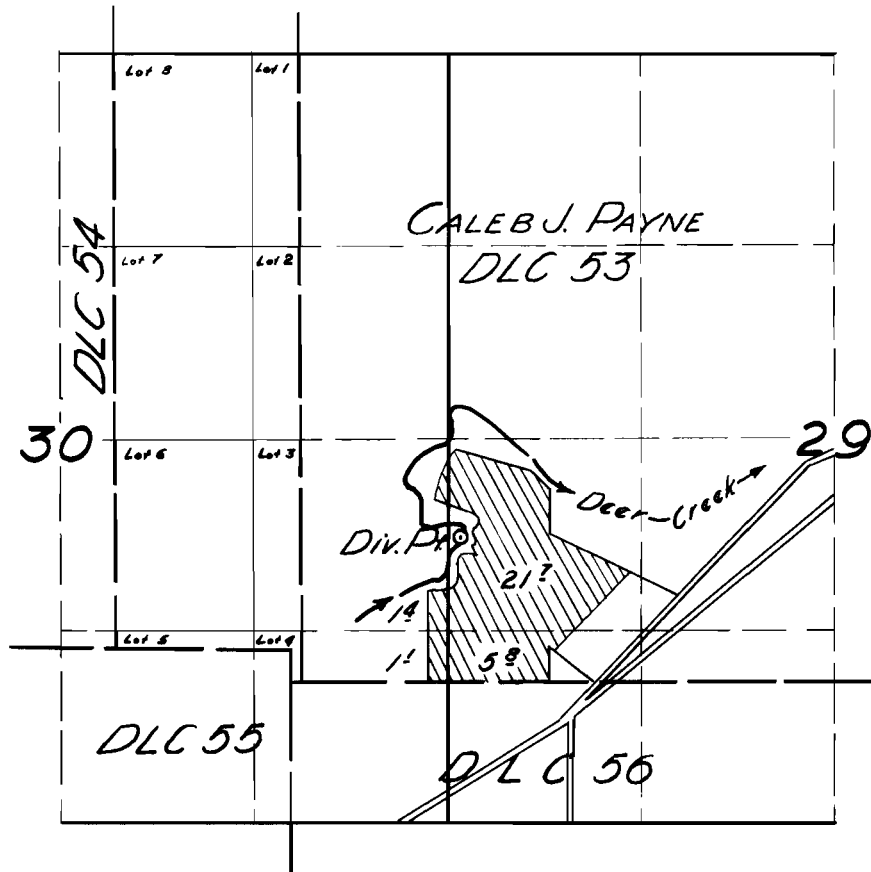

**FINAL PROOF SURVEY**

UNDER

Application No. 26708 Permit No. 20907

IN NAME OF

MORRIS & MARIE MAJORS

Surveyed 22 Mar. 1956, by C. A. Kelly