


T. 4 S. R. 1 W. W. M.

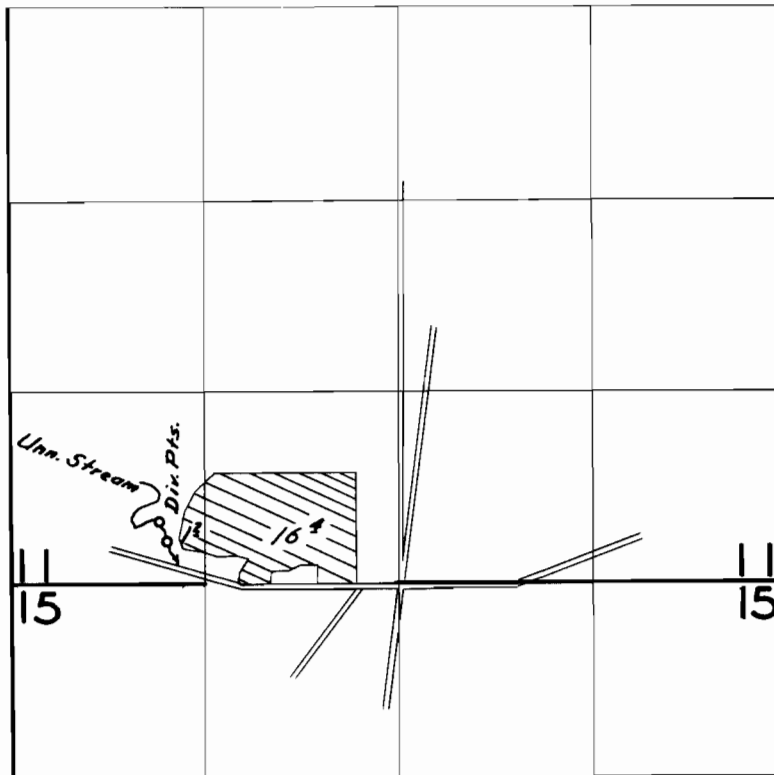

FINAL PROOF SURVEY

UNDER

Application No. *26117* Permit No. *20988*

IN NAME OF

Mrs. Margaret D. Bland

Surveyed *June 21, 1956*, by *G. O. Bartels*