


T. 4 S. R. 1 W. W.M.

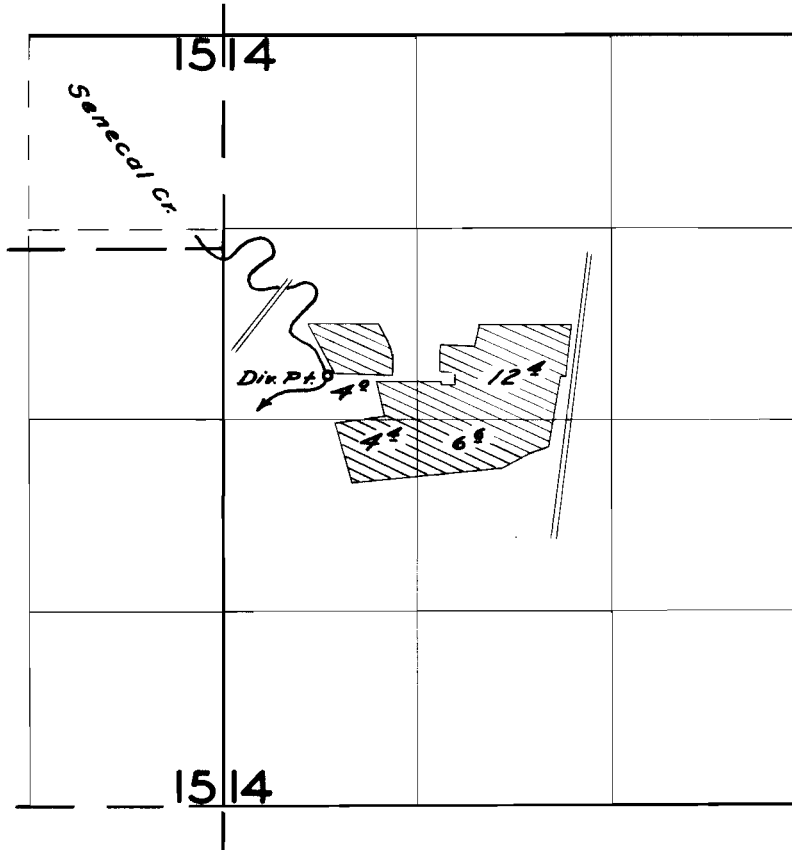

FINAL PROOF SURVEY

UNDER

Application No. 26878 Permit No. 21103

IN NAME OF

Paul Emil

Surveyed June 21 1956, by C. O. Bartels