


T.6 N. R. 6 W. W. M.

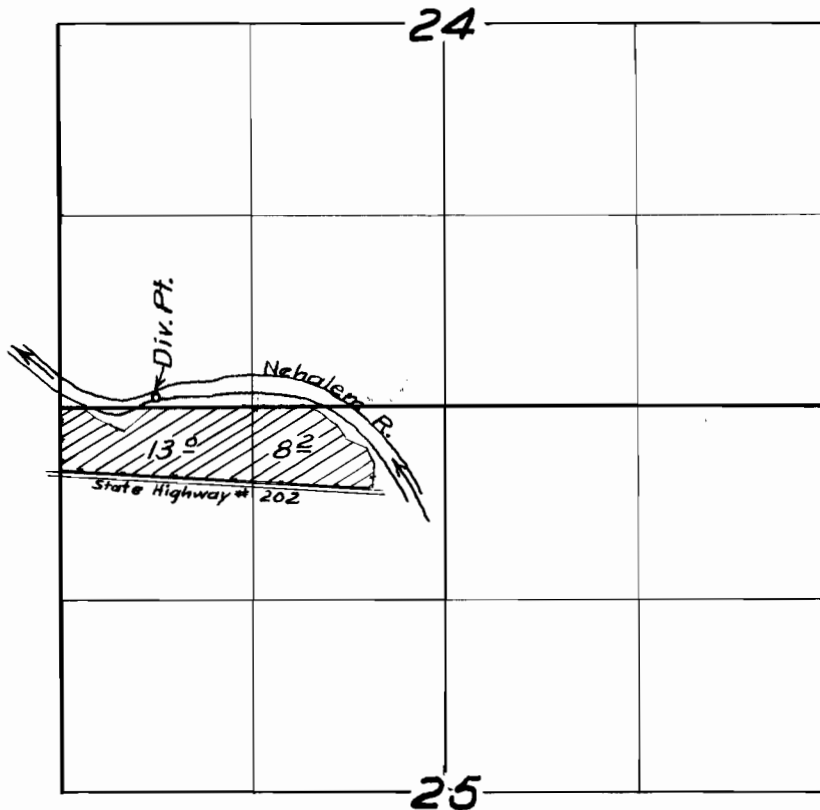

FINAL PROOF SURVEY

UNDER

Application No. 27130 Permit No. 21342

IN NAME OF

Berg Brothers

Surveyed Aug. 17 1956, by J. M. Bish