


T.5 N. R. 7 W. W. M.

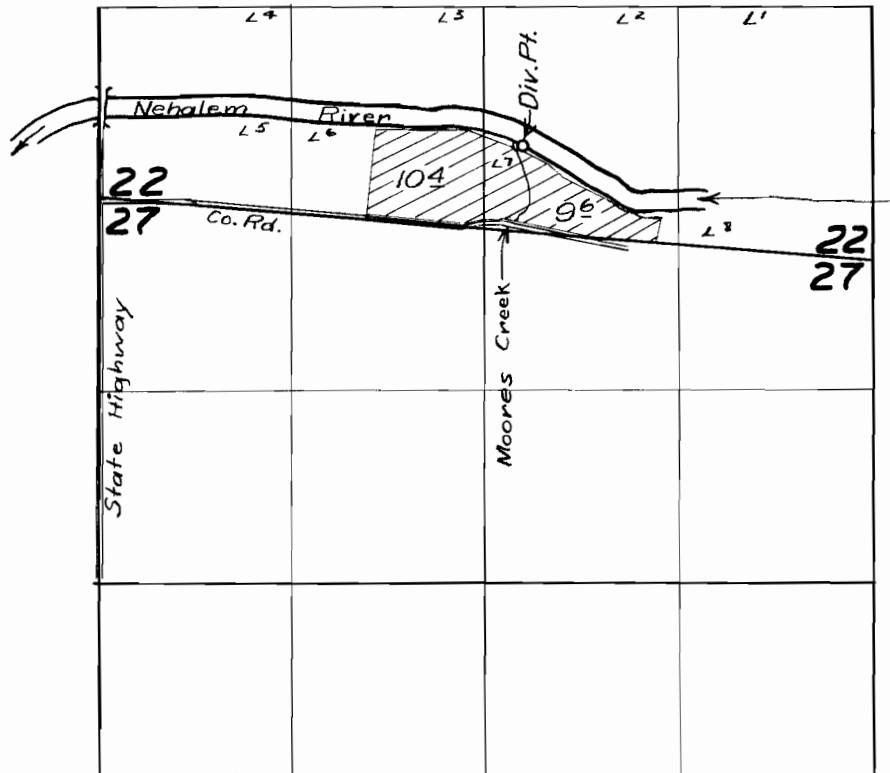

FINAL PROOF SURVEY
UNDER

Application No. 27179 Permit No. 21375
IN NAME OF

Herbert Rodgers

Surveyed 10 July 1956 by *M. Bish*