


T. 6 S R. 1 W W.M.

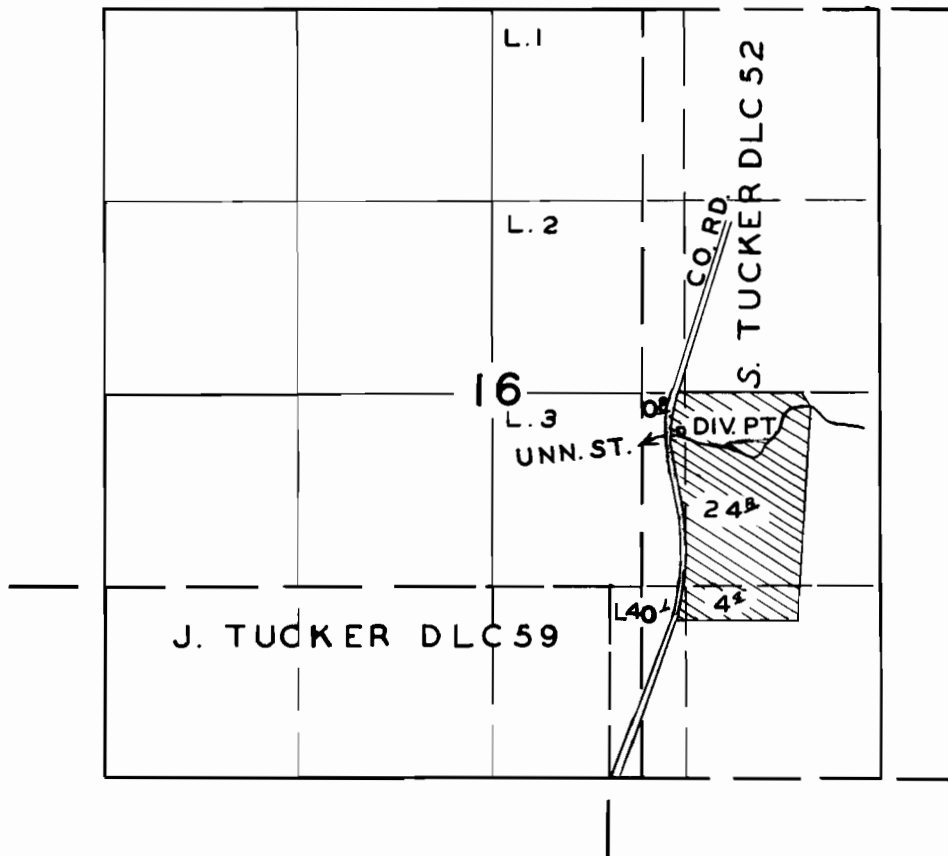

FINAL PROOF SURVEY

UNDER

Application No. 24942 Permit No. 21571

IN NAME OF

WILLIAM H. SCHWARZ

Surveyed JUNE 7 1956, by R. H. WHITBY