


T. 5 S. R. 3 W. W.M.

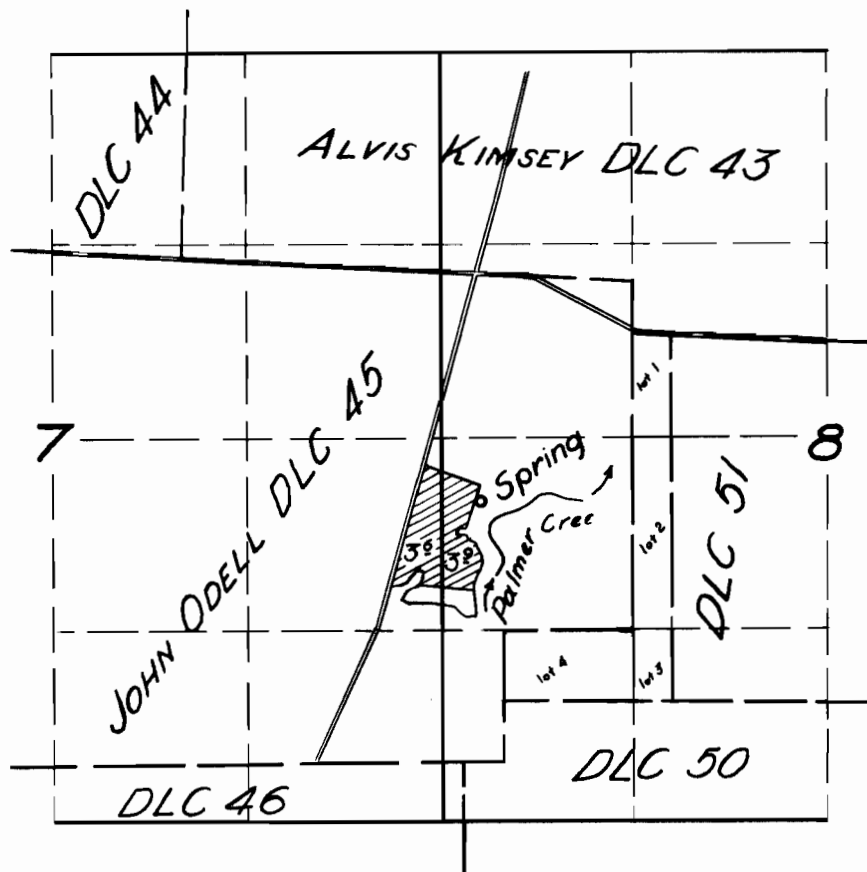

FINAL PROOF SURVEY
UNDER

Application No. 27417 Permit No. 21587
IN NAME OF

JOHN MCLAUGHLIN

Surveyed 15 Mar. 1956 by *[Signature]*