


T. 4 N. R. 7 W. W. M.

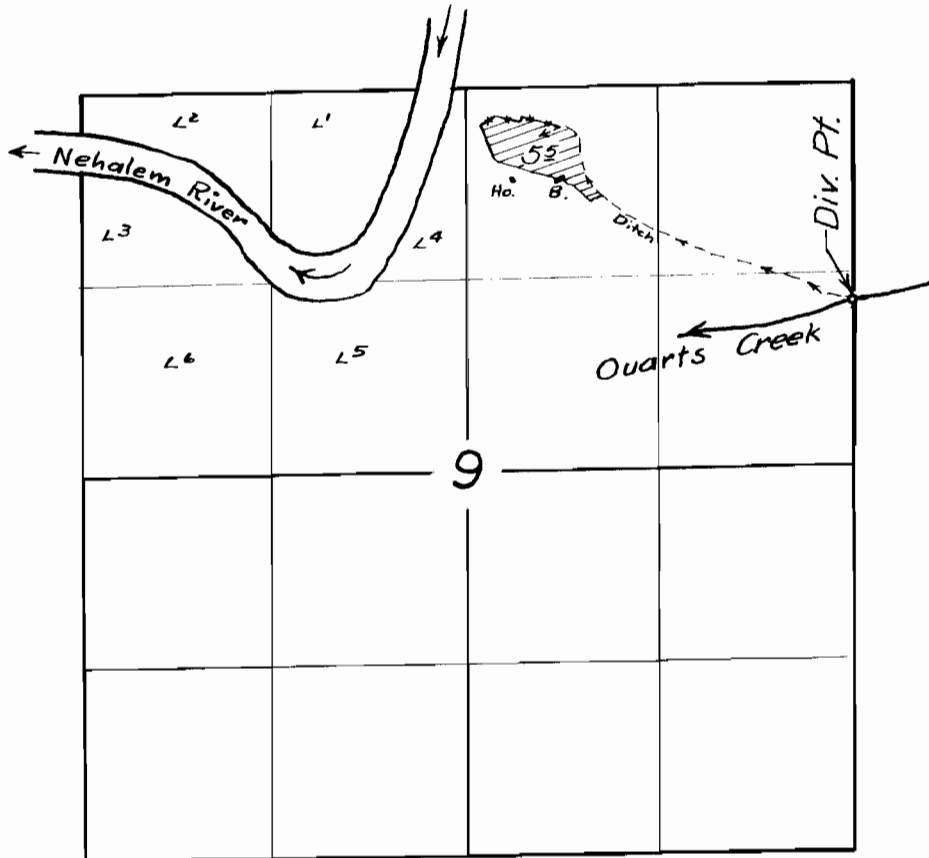

FINAL PROOF SURVEY

UNDER

Application No. 27419 Permit No. 21589

IN NAME OF

Henry Gronnel

Surveyed 28 June 1956, by *M. B. Bish*