


T. 1 N. R. 3 E. W. M

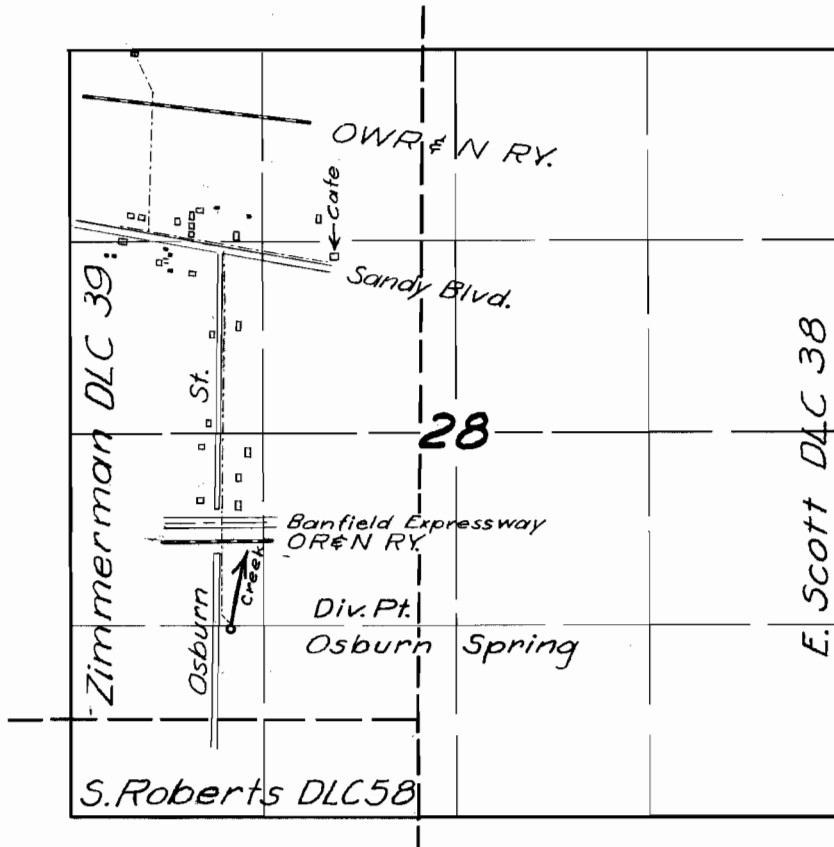

Ho. Trailer -  
Cottage ■  
House □

### FINAL PROOF SURVEY

UNDER

Application No. 27548.. Permit No. 21728..

IN NAME OF

*Paul P. Jr. & Elsie Wilene Schatz*

Surveyed 26 July 1956, by *Tom Bish*