


T. 4 S. R. 6 W. W. M.

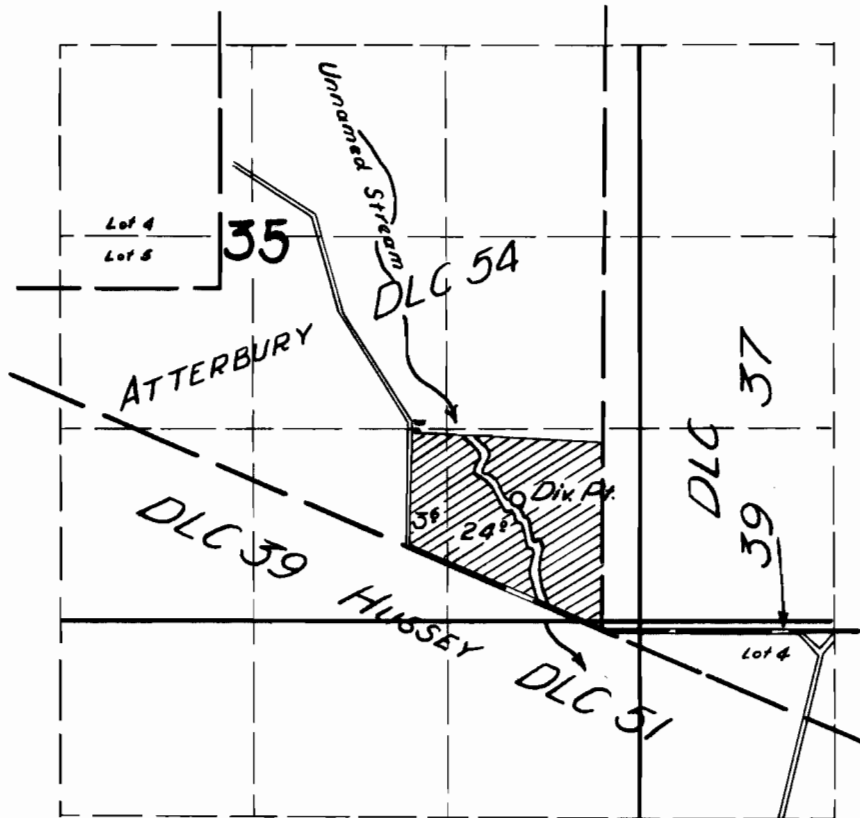

FINAL PROOF SURVEY

UNDER

Application No. 27667 Permit No. 21787

IN NAME OF

LEO F. DENZEL

Surveyed 28 Mar. 19. 56, by