


T. 5 & 6 S. R. 6 W. W. M.

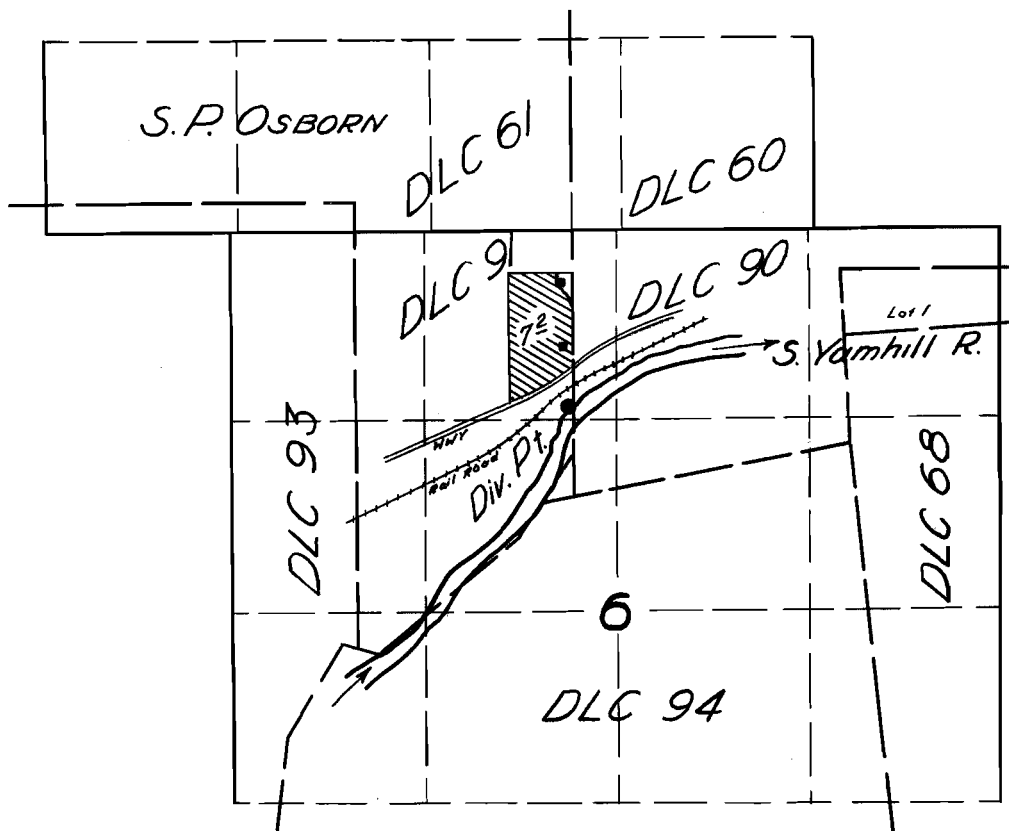

**FINAL PROOF SURVEY**  
UNDER

Application No. 27730 Permit No. 21842

IN NAME OF

RALPH E. BUNN

Surveyed 9 Mar 1956, by

*[Signature]*