


T. 2 S. R. 4 & 5 W. W. M.

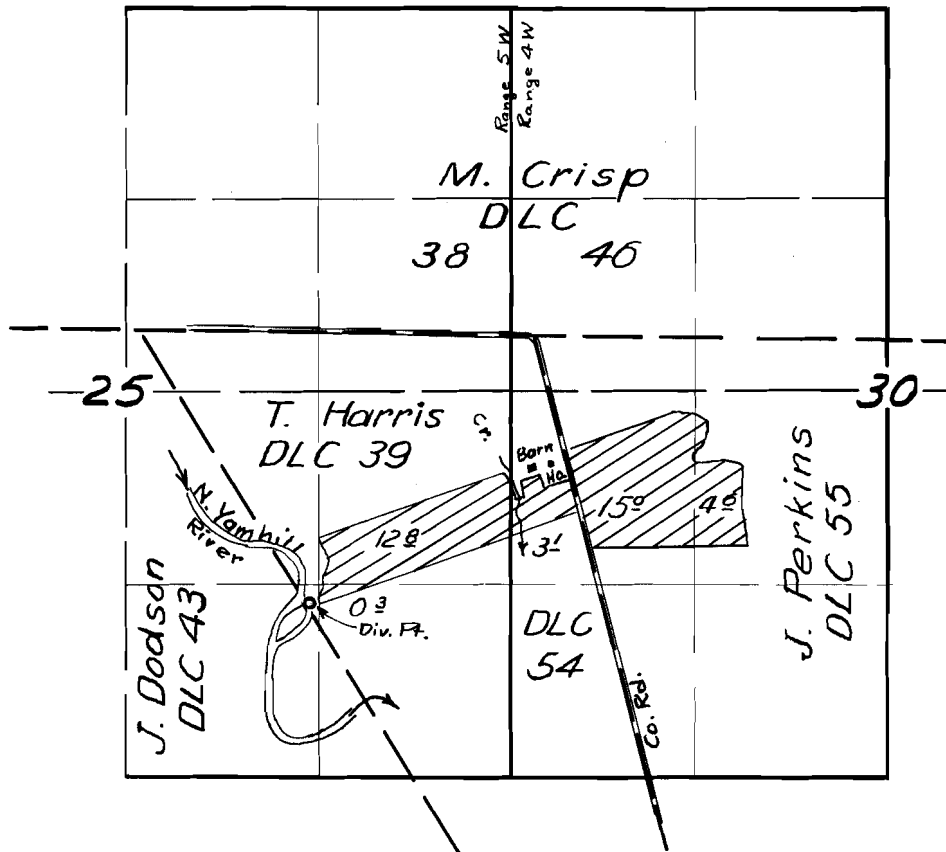

FINAL PROOF SURVEY
UNDER

Application No. 27845 Permit No. 21898
IN NAME OF

Waldron A. Johnson

Surveyed 4 April 1956, by Tom Besh