


TIN, RAW, WM.

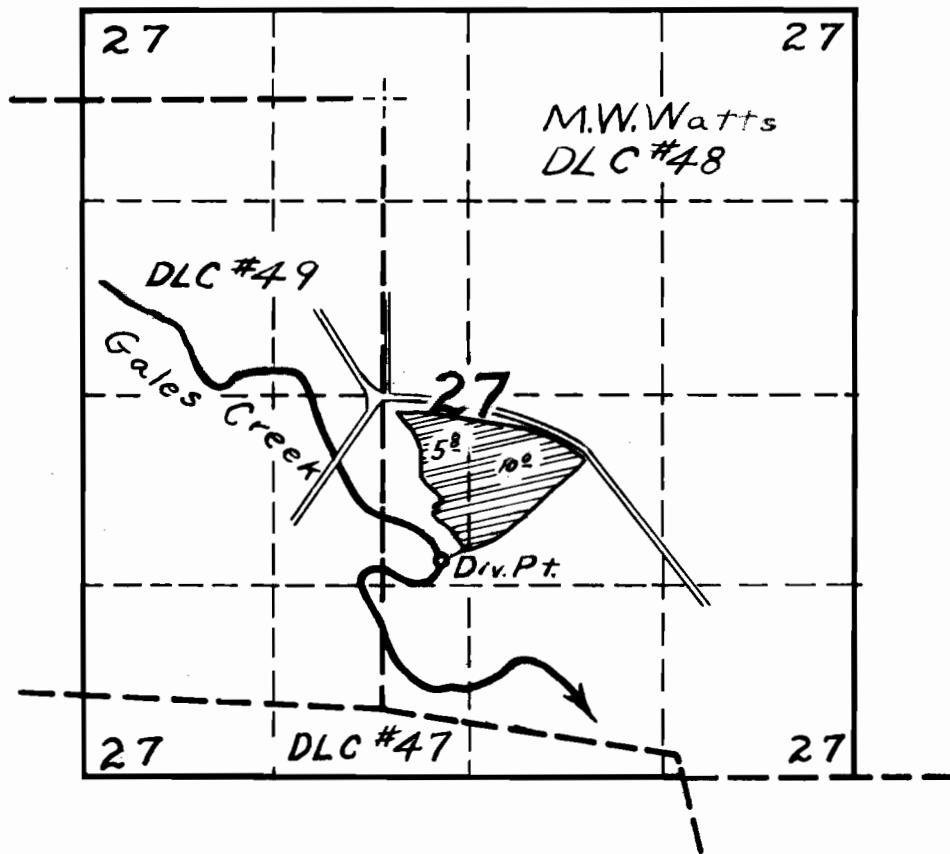

FINAL PROOF SURVEY

UNDER

Application No. 28199 Permit No. 22188

IN NAME OF

Bernard J. Larson

Surveyed 4-10 1956, by R.D.Best