


T.29S. R.8W.W.M.

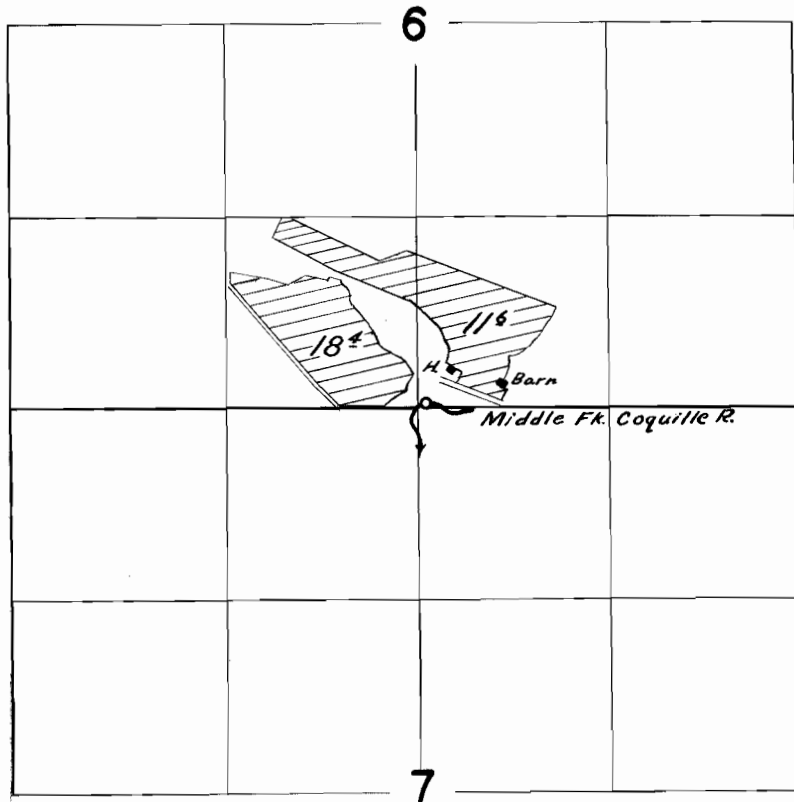

FINAL PROOF SURVEY

UNDER

Application No. *28207*.. Permit No. *22195*..

IN NAME OF

HARRY C. BOYLE

Surveyed *Aug. 27, 1956*, by *C. O. Bartels*