


T. 4S. R. 1E. W.M.

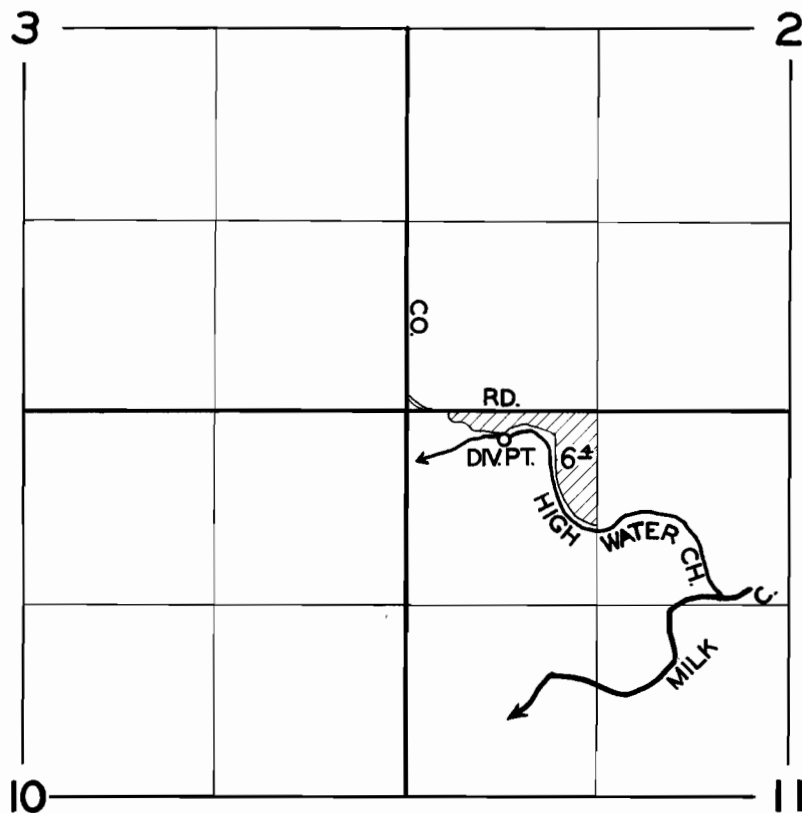

FINAL PROOF SURVEY
UNDER

Application No. **28293** Permit No. **22245**
IN NAME OF

HARLAN RUPP.

Surveyed **9 MAR. 1956** by **R. D. BEST**