


T.29S. R.8 W.W.M.

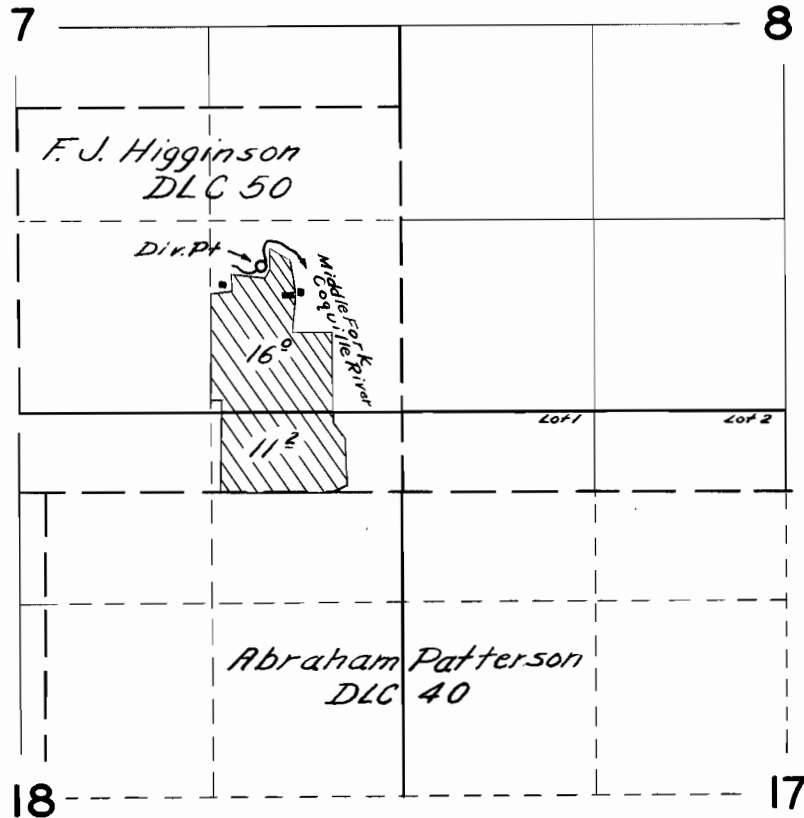

**FINAL PROOF SURVEY**

UNDER

Application No. 28473 Permit No. 22300

IN NAME OF

Neal C. Brown

Surveyed Aug. 27, 1956, by C. D. Bartels