


T. 4 & 5 N. R. 7 W. W.M.

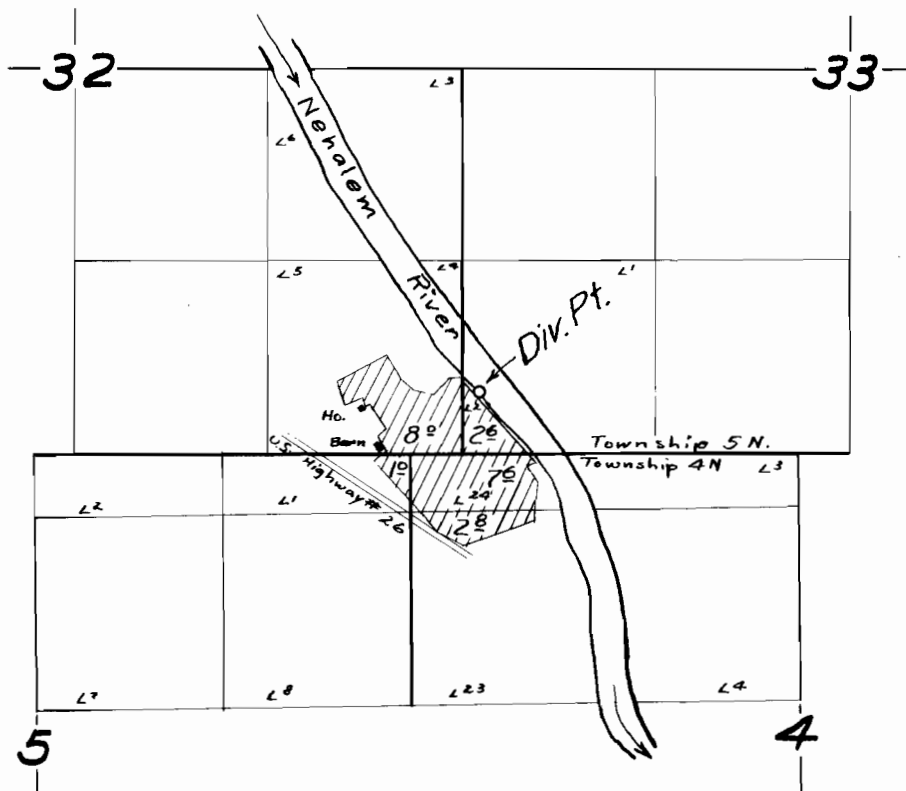

**FINAL PROOF SURVEY**  
UNDER

Application No. 28464 Permit No. 22495  
IN NAME OF

Leslie W. Gollersrud

Surveyed 9 July 1956, by M. Bish