


T.28S. R.6W.W.M.

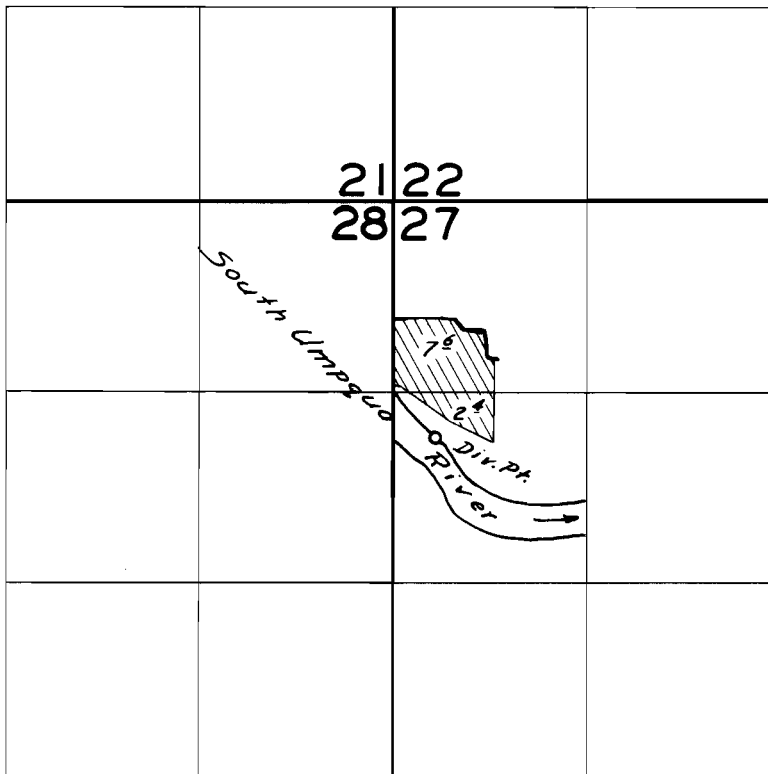

FINAL PROOF SURVEY

UNDER

Application No. 28588. Permit No. 22526.

IN NAME OF

Lewis J. Fullerton

Surveyed Aug. 2, 1956, by *C. O. Bartels*.