


T.29S R.5W.W.

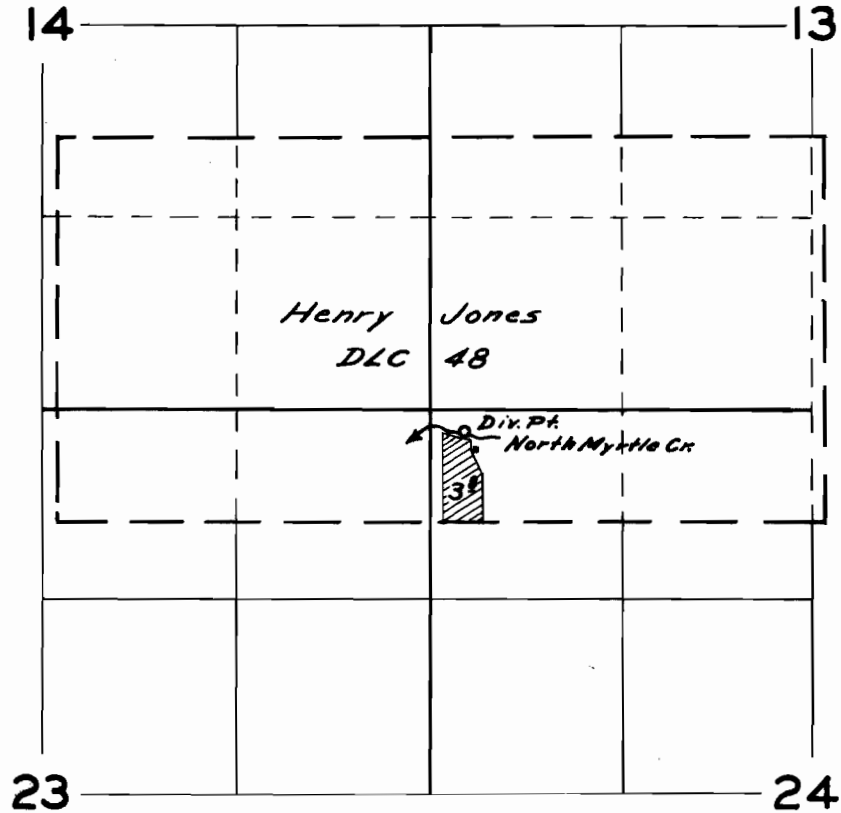

FINAL PROOF SURVEY
UNDER

Application No. 28736 Permit No. 22612
IN NAME OF

Jason F. Schmalz

Surveyed Aug. 22 1956, by C.O. Bartels