


T.3S. R.3 W.W.M.

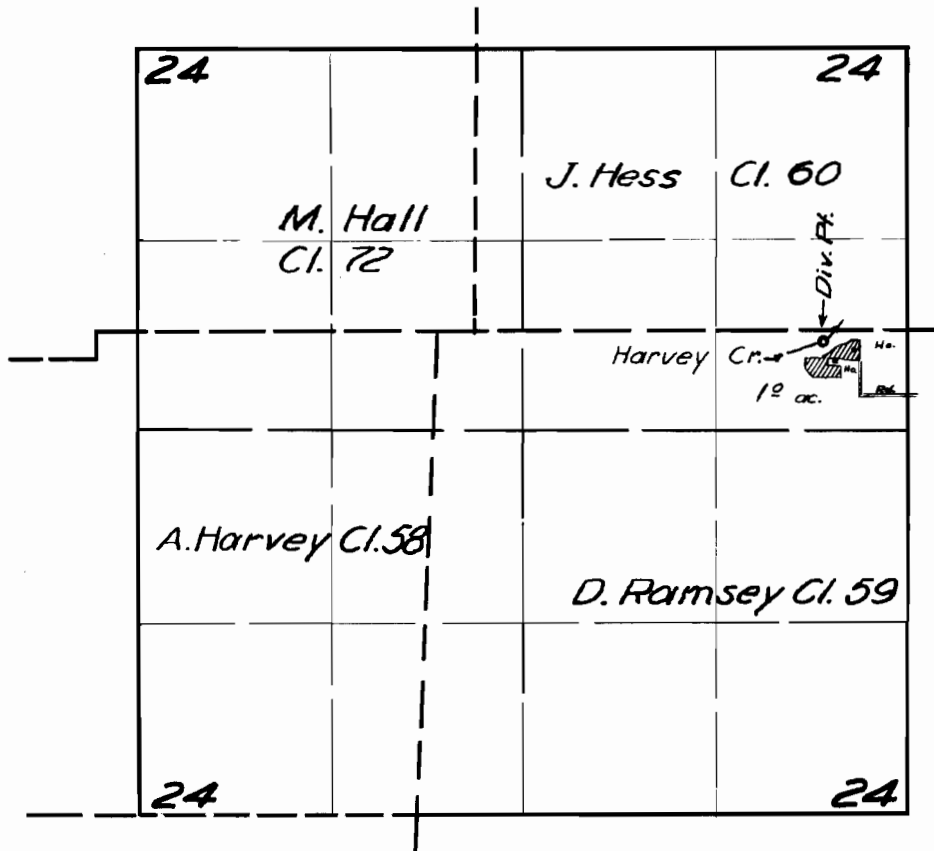

**FINAL PROOF SURVEY**

UNDER

Application No. 28829 Permit No. 22686

IN NAME OF

Fred Rader

Surveyed Mar. 22 1956, by M. Bish