


T.6S. R.1W.W.M.

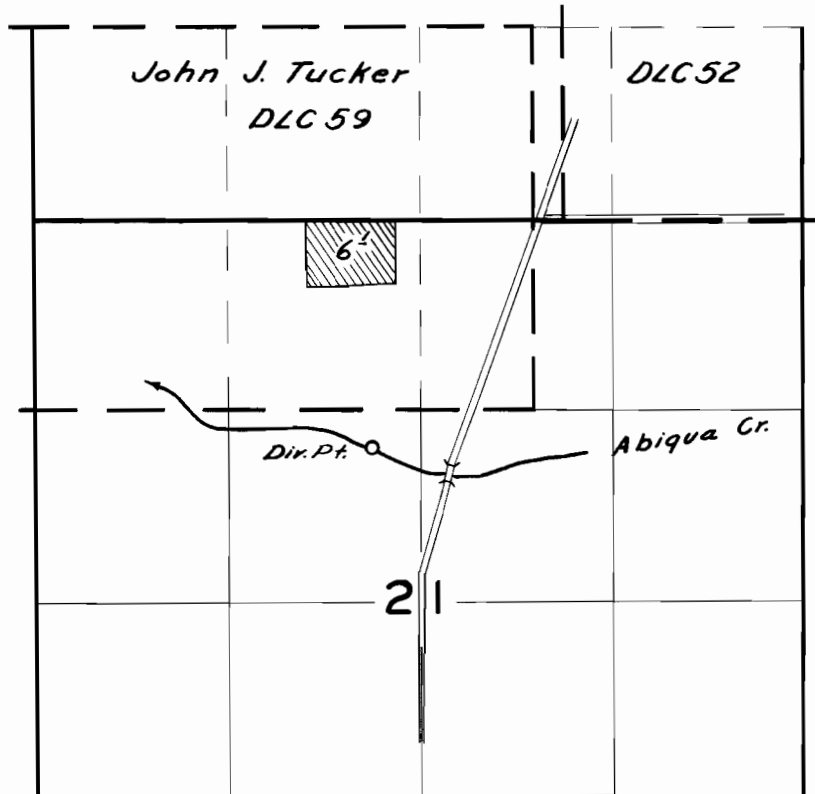

FINAL PROOF SURVEY

UNDER

Application No. 29863 Permit No. 23526
IN NAME OF

William H. Schwarz

Surveyed May 22 1956, by C. O. Bartels