


T.2 S. R. 5 W.W.M.

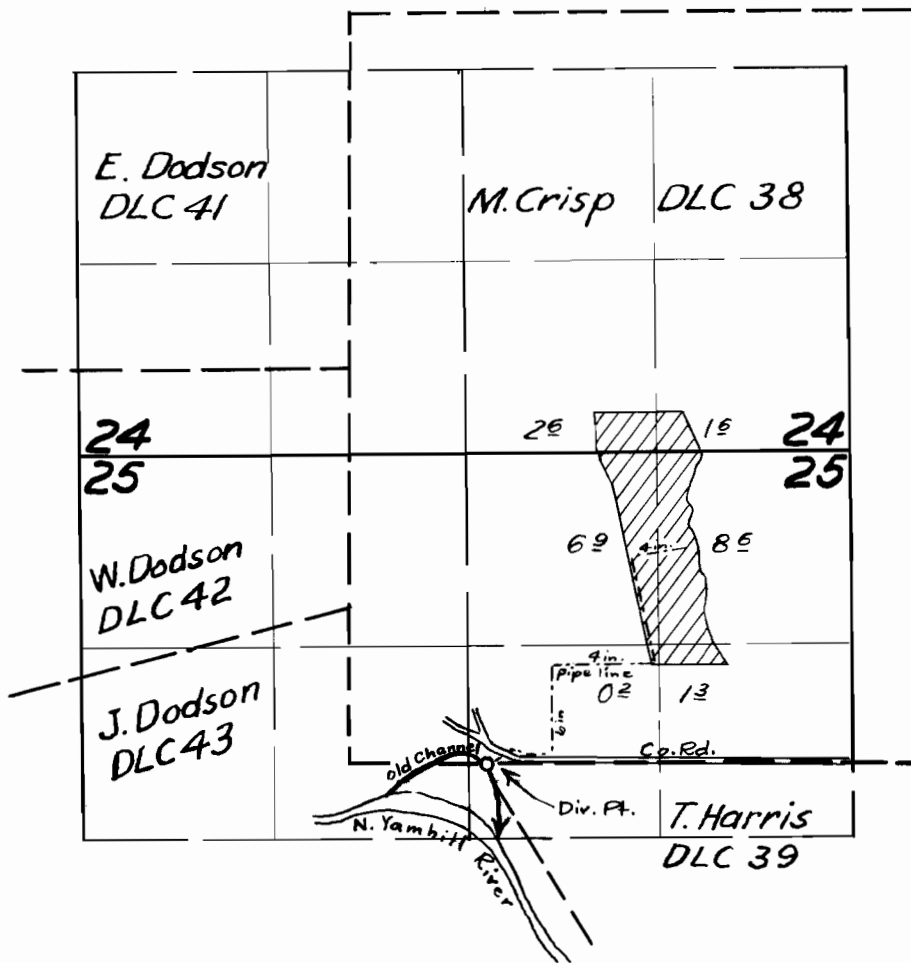

FINAL PROOF SURVEY
UNDER

Application No. 29948 Permit No. 23595
IN NAME OF

Frank Geisler

Surveyed 3 April 1956, by M. Bish