


T. 26 S. R. 6 W. W.M.

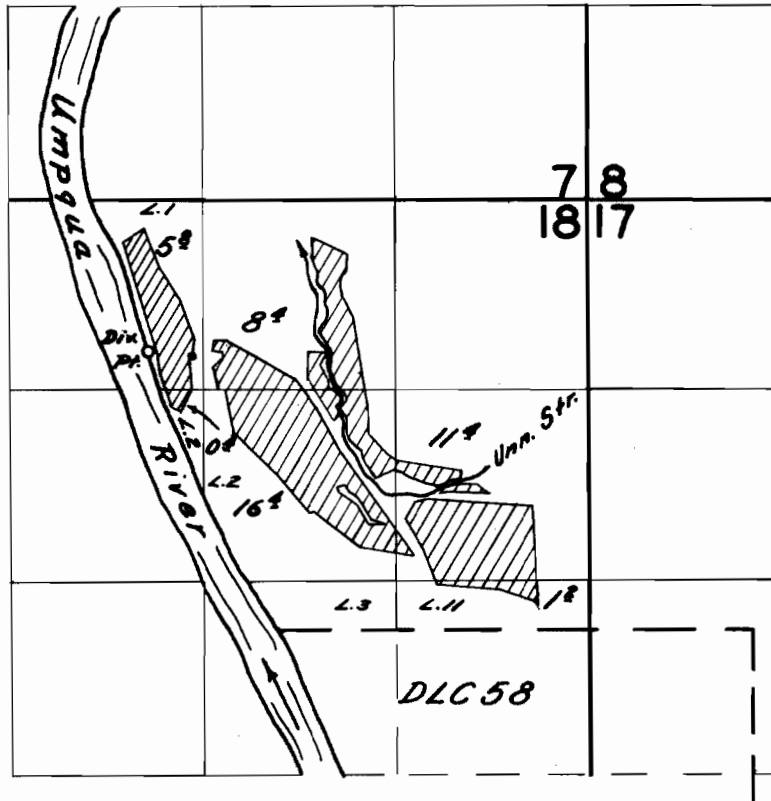

FINAL PROOF SURVEY

UNDER

Application No. 30075 Permit No. 23703

IN NAME OF

Gerald Bacon

Surveyed June 14 1956, by C.O. Bartels