


T. 4 - 5 N R. 4 W W.M.

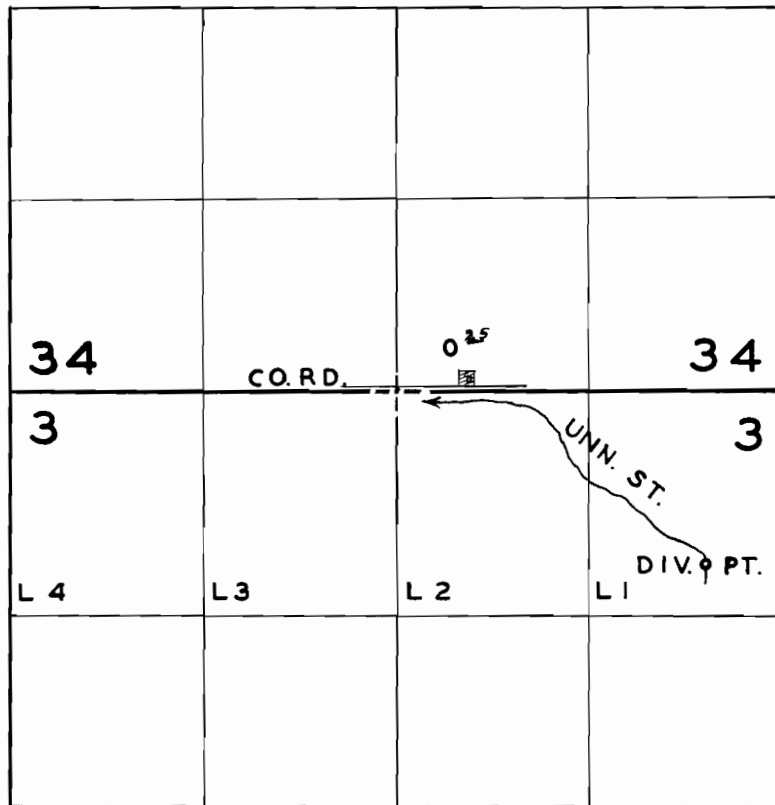

**FINAL PROOF SURVEY**  
UNDER

Application No. 26312 Permit No. 20652  
IN NAME OF

**JOHN<sup>A</sup><sub>D</sub> MINNE KRINICK**

Surveyed SEPT. 12 1956, by R.H. WHITBY