


T. 4 & 5 S. R. 6 W. W.M.

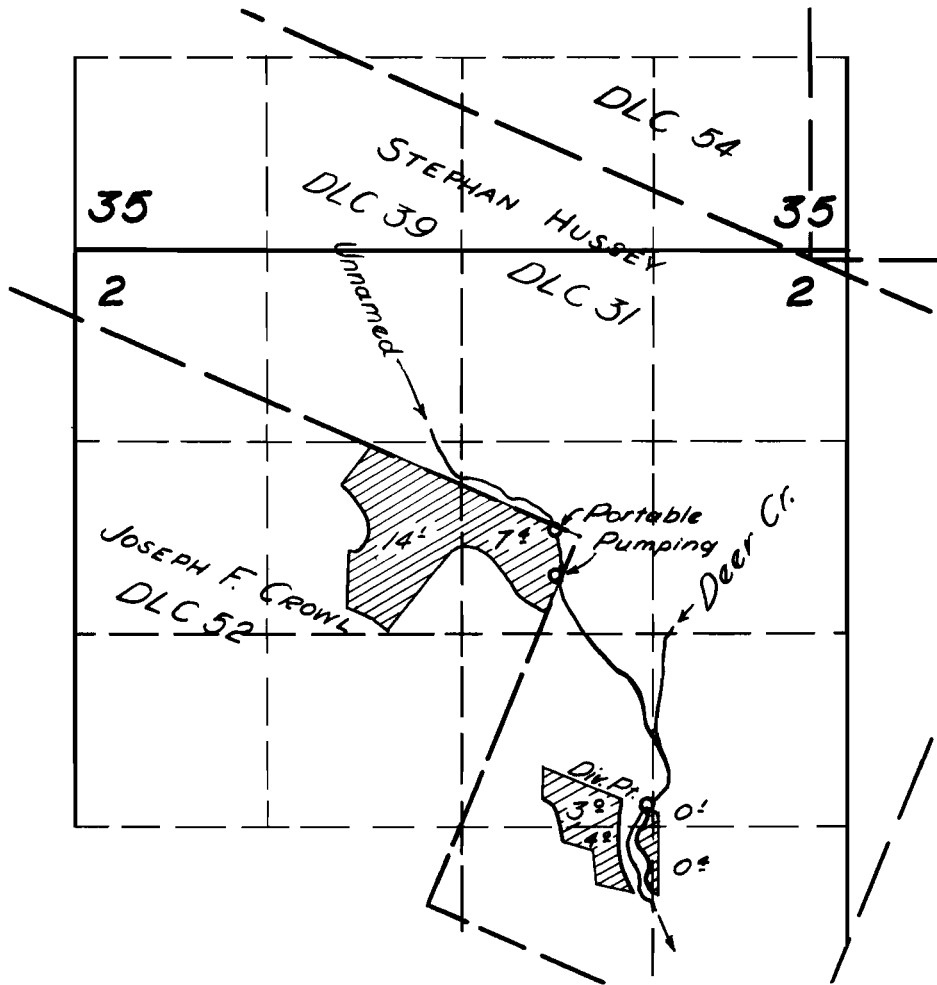

**FINAL PROOF SURVEY**

UNDER

Application No. 26484 Permit No. 20758

IN NAME OF

CECIL & DELORES GROSS

Surveyed 13 Mar. 1956, by R. H. Whitby

Note: This map layout  
is in error -

Section 2 is short in  
the top 40's - This  
map was drawn with  
standard 40 for the  
top 40's