


T. 6 & 7 S. R. 2 W. W. M.

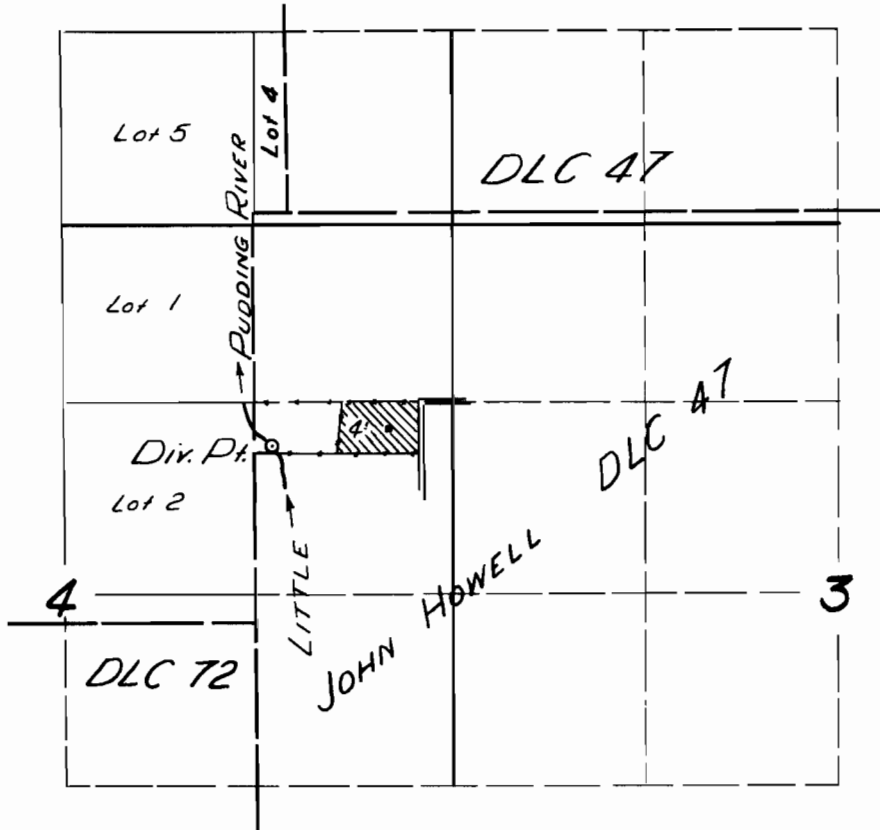

FINAL PROOF SURVEY

UNDER

Application No. 26489 Permit No. 20760

IN NAME OF

CHARLES J. PETERSON

Surveyed 23 May 1956, by