


T. 5S. R. 2E. W.M.

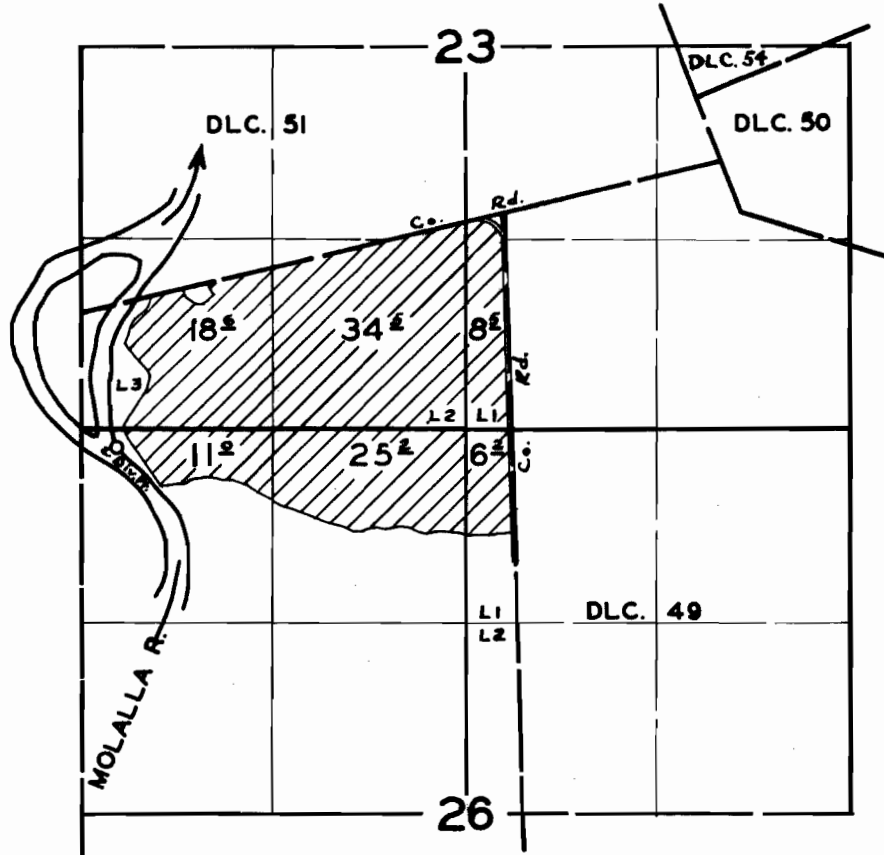

FINAL PROOF SURVEY
UNDER

Application No. 26729 Permit No. 20918
IN NAME OF

ED & JACK FEYRER

Surveyed 28 Mar. 1956, by R. O. Best

2-18