


T.4S.R.3E.W.M.

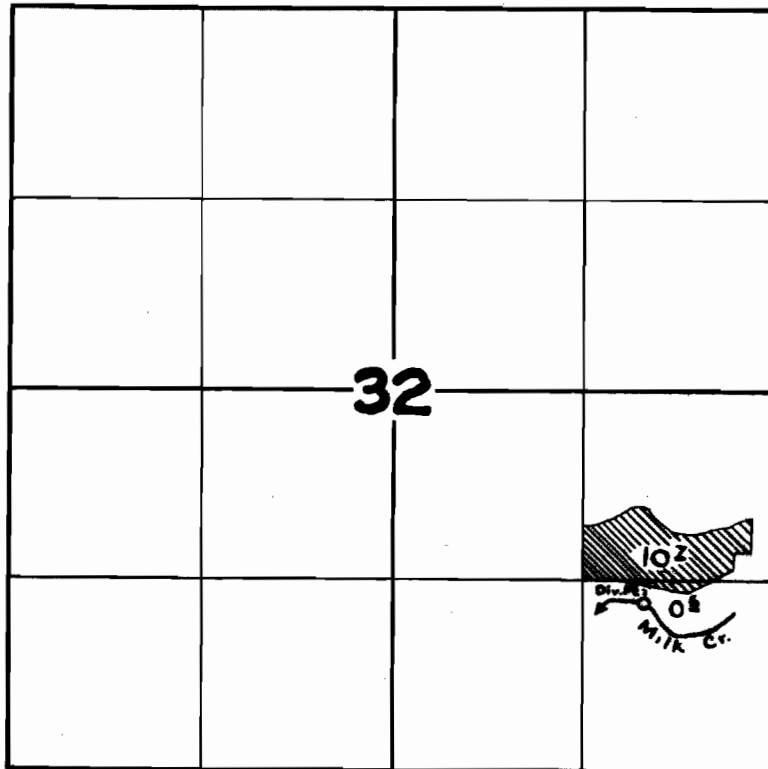

FINAL PROOF SURVEY
UNDER

Application No. 26895 Permit No. 21133

IN NAME OF

RAYMOND HILL

Surveyed 15 Mar. 1956, by R. D. Best