


T. 2 S. R. 5 E. W. M.

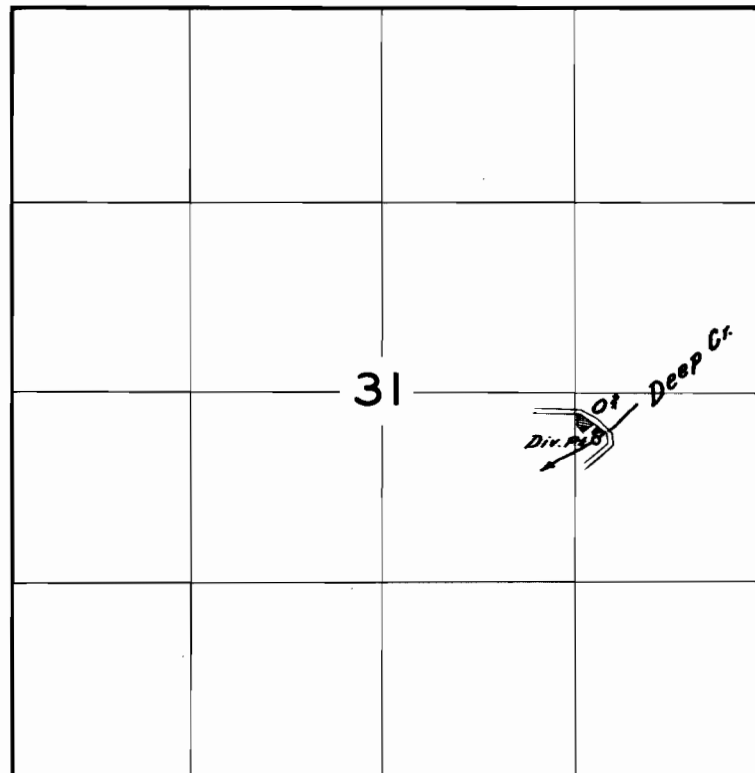

FINAL PROOF SURVEY

UNDER

Application No. 24965... Permit No. 21182....
IN NAME OF

.....*ALBERT HORGER*.....

Surveyed *June 12* 19*56*, by *R.H. Whitby*.

DFK-4D-82

C.B.