


T. 6 S. R. 1 W. W. M.

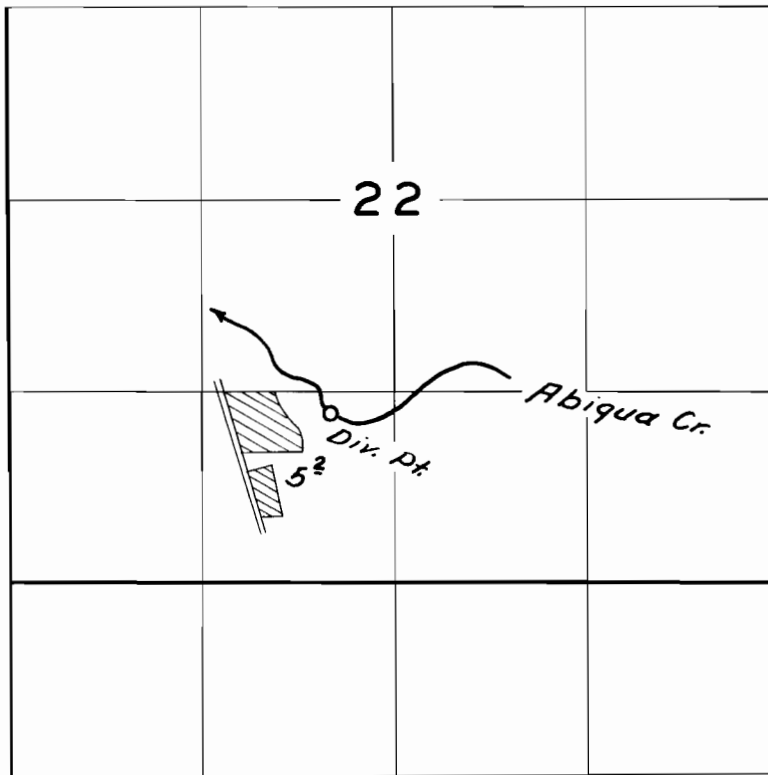

FINAL PROOF SURVEY

UNDER

Application No. 26980 Permit No. 21193

IN NAME OF

Leo D. Steffen

Surveyed May 23 1956, by C.O. Bartels