


T. 2 S. R. 2 E. W.M.

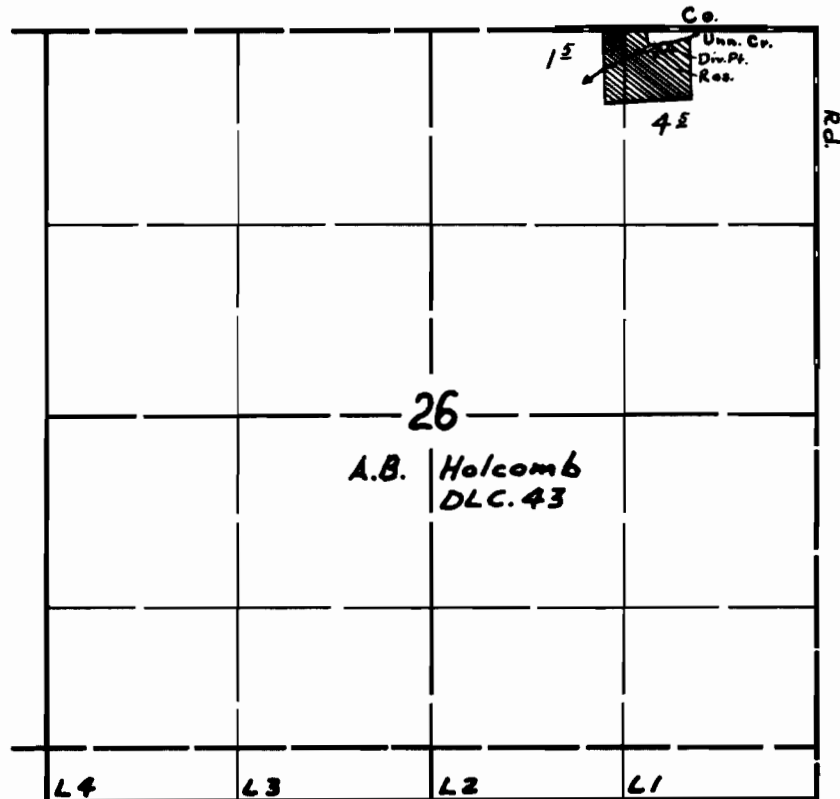

FINAL PROOF SURVEY
UNDER

Application No. 26997 Permit No. 21204
IN NAME OF

A. G. Withey

Surveyed 18 June 1956, by M. Bish

DFK-1D-43