


T. 30 S. R. 5 W. W. M.

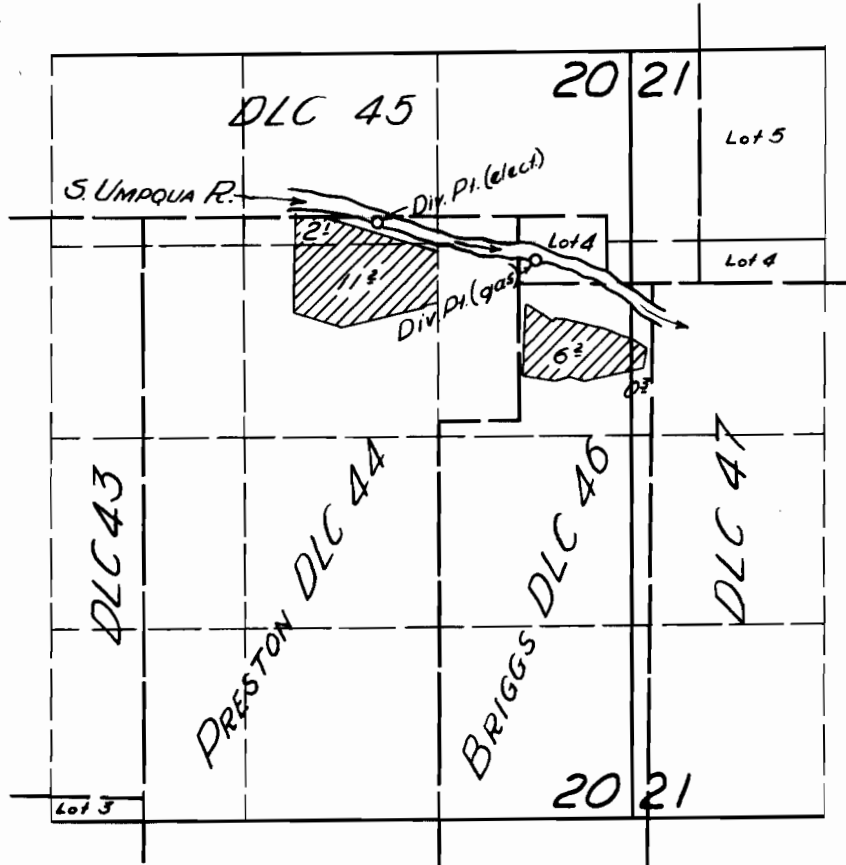

FINAL PROOF SURVEY

UNDER

Application No. 20988 Permit No. 21263

IN NAME OF

CLEM TAVENNER

Surveyed 13 Oct. 1956, by