


T. 3S. R. 1W. WM.

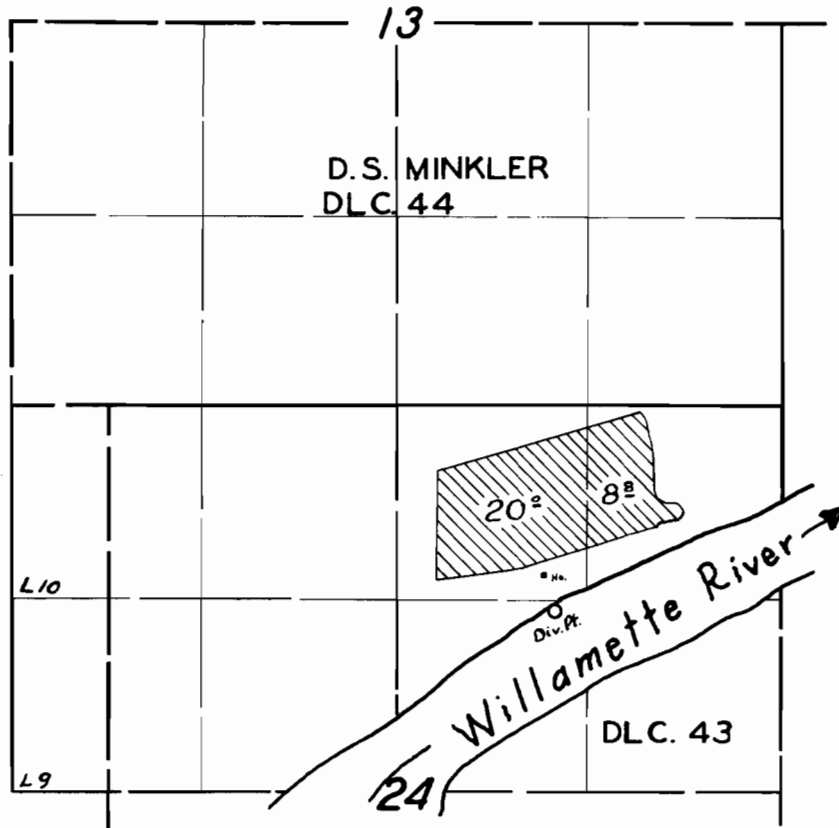

FINAL PROOF SURVEY
UNDER

Application No. 27054 Permit No. 21288

IN NAME OF

JULIUS A. & MARGARET T. BILDSTEIN

Surveyed 26 June 1956, by M. Bish

Handwritten initials