


T.10S. R.2 W.W.M.

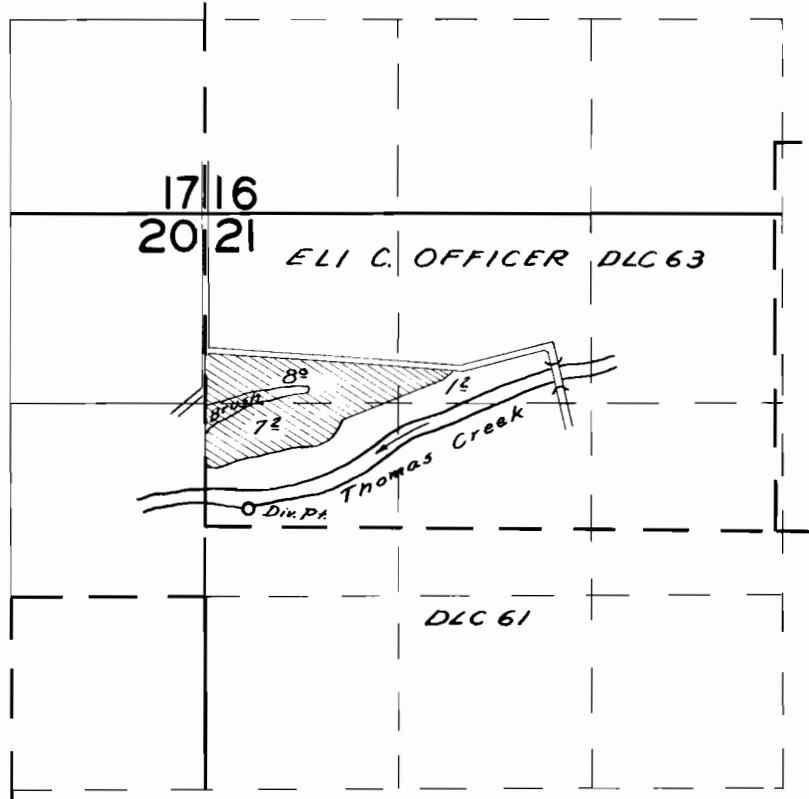

FINAL PROOF SURVEY

UNDER

Application No. 22238 Permit No. 21431

IN NAME OF

BEN J. OLSEN

Surveyed July 24, 1956, by *C.O. Bartels*