


T.3N. R.2W.W.M.

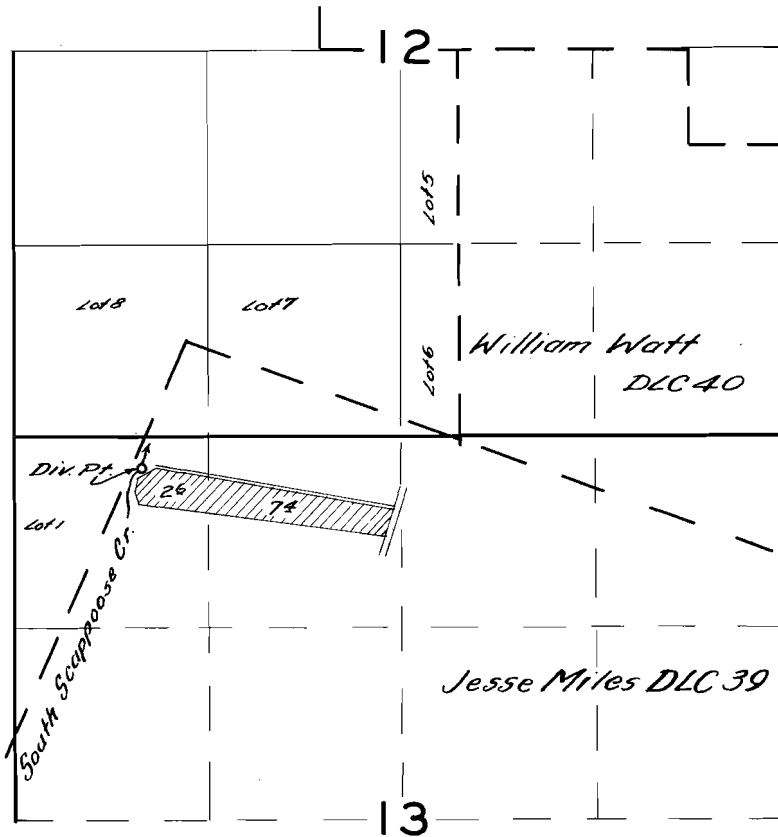

FINAL PROOF SURVEY

UNDER

Application No. 27478 Permit No. 21630

IN NAME OF

JOE A. FISCHER

Surveyed Aug. 1, 1956, by R.H. Wilby

1956-V