


T. 3 S. R. 3 E. W. M.

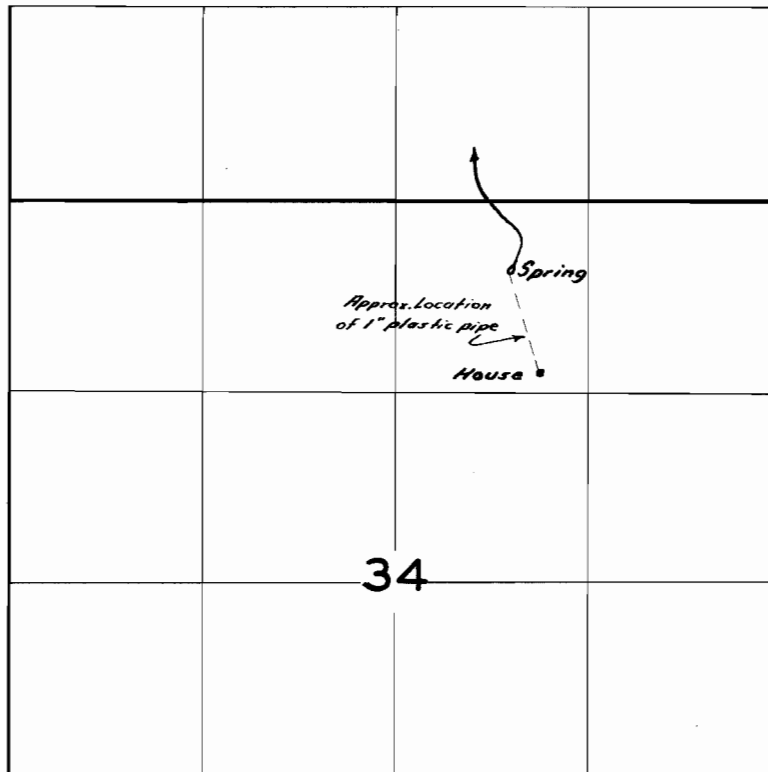

FINAL PROOF SURVEY

UNDER

Application No. *27551* Permit No. *21729*

IN NAME OF

G. A. Bailey

Surveyed *Sept. 25, 1956*, by *C. O. Bartels*