


T. 2 S. R. 4 & 5 W. W. M.

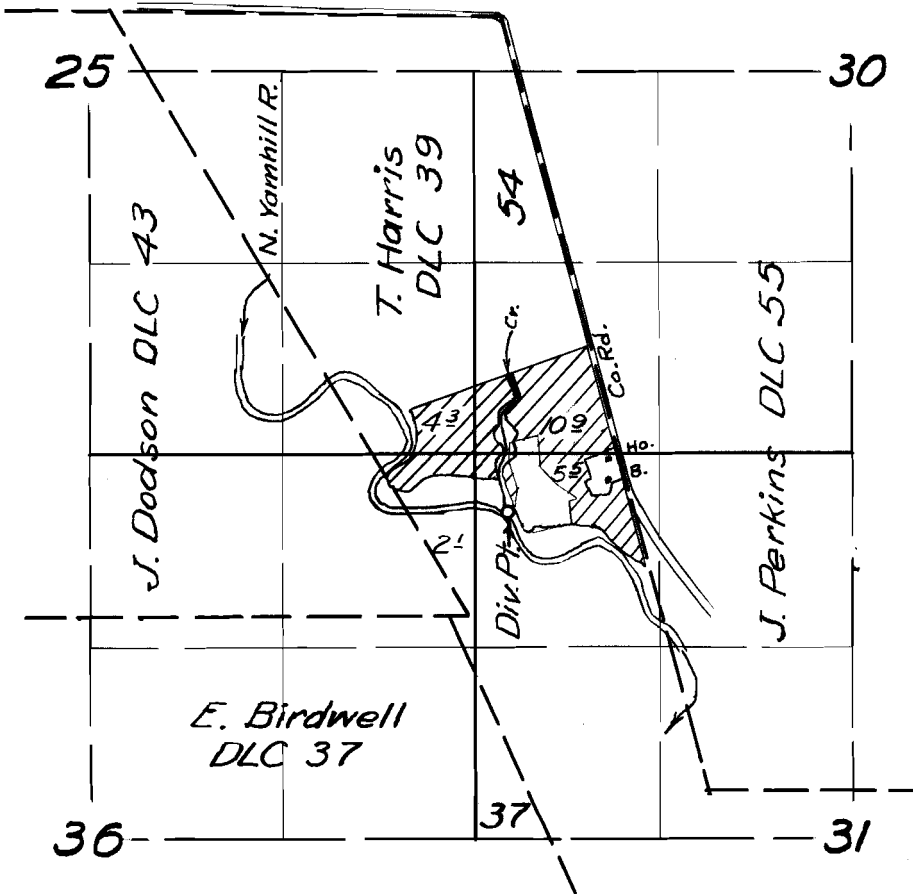

**FINAL PROOF SURVEY**  
UNDER

Application No. 27976 Permit No. 22020  
IN NAME OF

Ernest H. Robertson

Surveyed 4 April 1956, by Tr. Bish