


T. 3S. R. 1W. W.M.

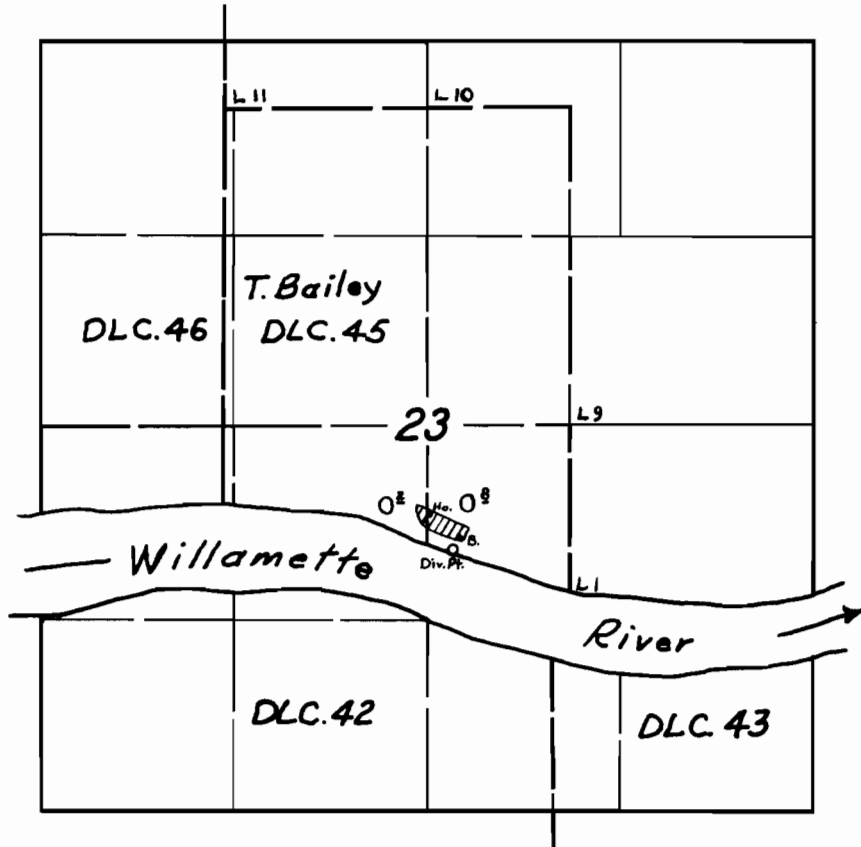

FINAL PROOF SURVEY
UNDER

Application No. 27432 Permit No. 22423
IN NAME OF _____

H. S. HARDING

Surveyed 16 May 1956, by M. Bish

DFK-2D-87

2005